Name #671 **Service No.**

Address ** 79 MIDDLE ST.

(NO ST. NO. ASSIGNED TO VAC. LOT. **Location** OPP # 80)

Kind of Pipe **Size** **Size of Main**

Repair **Renewal** **New Service** **Location**

Date		Material	Amount		Total		Date			Amount	

4.18501

DATE _____

TOWN OF LEXINGTON — BOARD OF PUBLIC WORKS

SEWER DIVISION

Sketch of Service Here

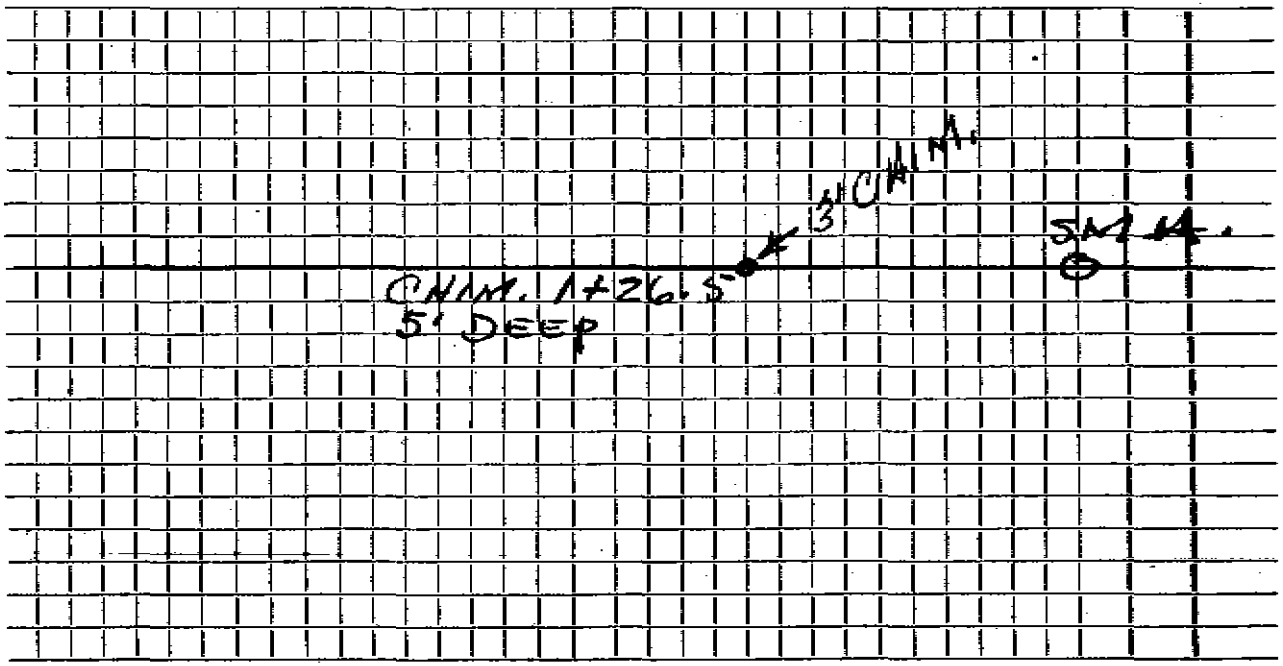

Connection made in ..... Street. Work completed .....

Remarks: .....

.....

.....