Name

Service No.

Address #34 Moonhill Rd.

34 Moon Hill Rd.

Location

Kind of Pipe A.C.

Size 6"

Size of Main 8"

Repair—Renewal—New Service

Location

Date		Material	Amount		Total		Date			Amount	
~~10-12~~	~~78~~	~~15' 6" A.C.P.~~ @	$ 19.	00	$ 285.	00					
							10-12-	78			
								15'	6" Transite		
								1	6" X 8" Wye		

H.B.M.18501

Sewer Ties
34 Moon Hill Rd
Not To scale

2011 Dave Santo

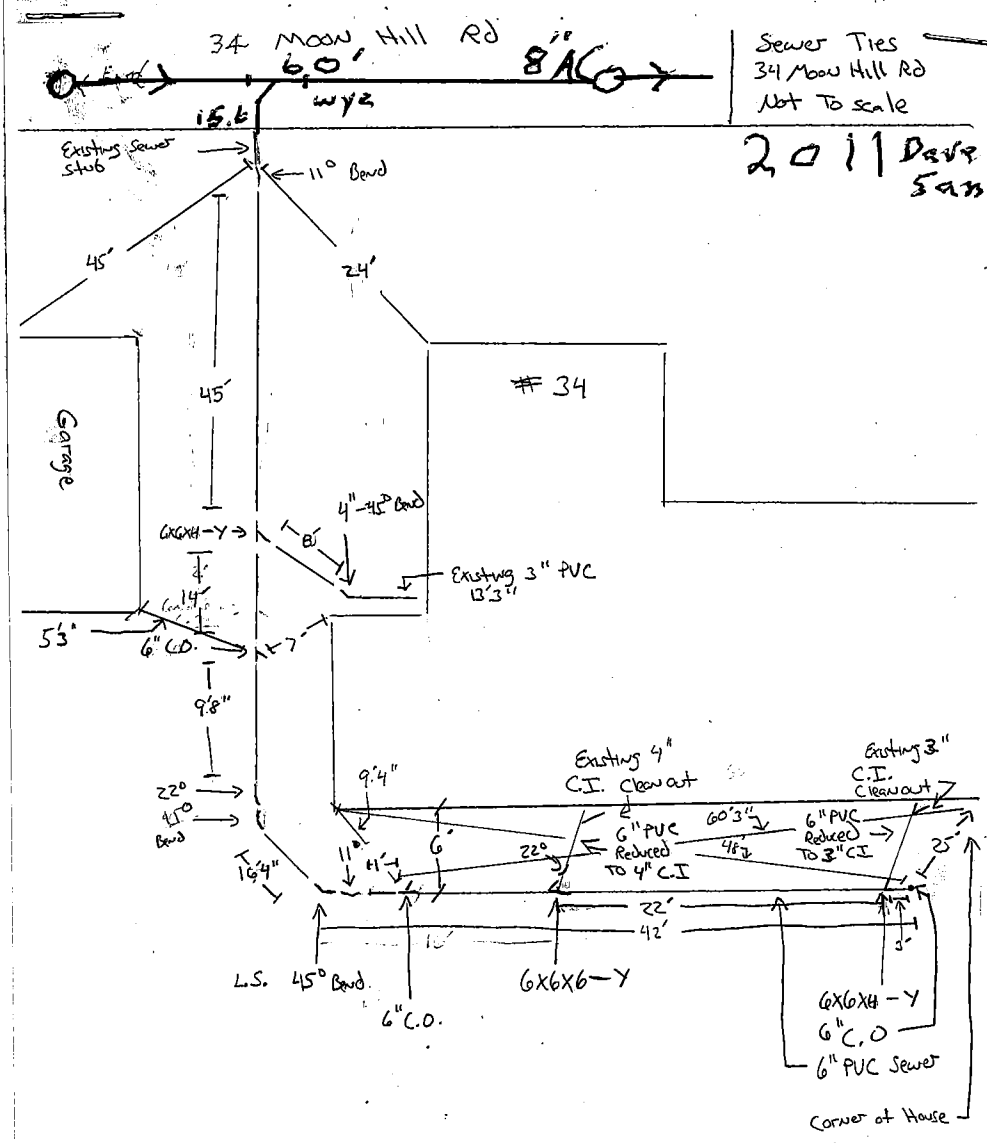

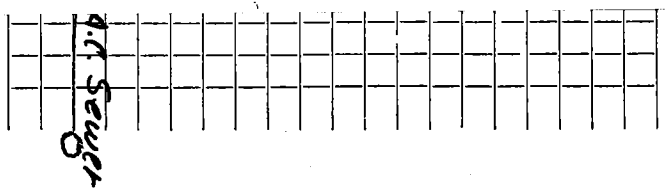

DATE
KS