Name Jan Leyenaar **Service No.** 73

Address #30 Moreland Ave

Location Lot 36

Kind of Pipe Russell A. Sibley **Size** **Size of Main**

[redacted] **New Service** Permit #A164 **Location** MAR 14 1966

Date		Material	Amount		Total		Date		Amount	
4-60		Labor	21	89			12-27-65	Deposit	50	00
		19% O.H.	2	19	24	08				
	16'	6" Transite pipe			11	20				
	1	6" 22½° Transite Elbow			2	24				
	1	Hr Town Shovel			6	50				
	1	Hr Allis Chalmers			3	00				
	1	Hr Trucking			3	00				
		Bill when Connected			50	02				
-66	14'	6" Transite pipe								

4.18501

DATE _____

TOWN OF LEXINGTON — BOARD OF PUBLIC WORKS

SEWER DIVISION

Sketch of Service Here 30

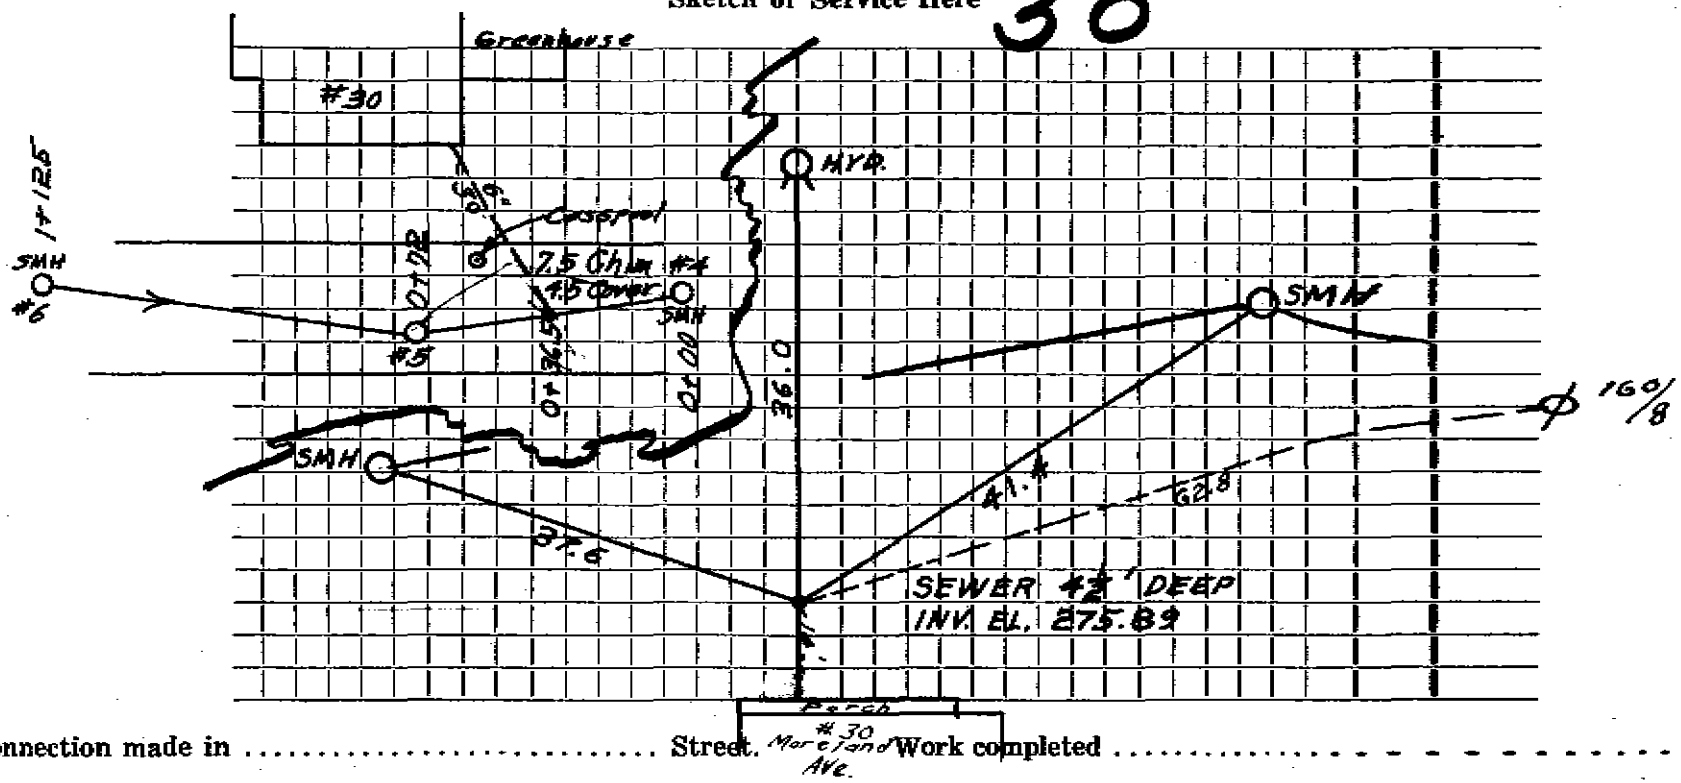

Connection made in ..... Street. Work completed .....

Remarks: .....

.....

.....