Name John Friedman **Service No.**

Address 38 Moreland Avenue

Location

Kind of Pipe **Size** 6" **Size of Main** 8"

Repair—Renewal—New Service Valeri #1528 **Location**

Date		Material	Amount	Total	Date			Amount
9-70	22'	6" Transite pipe						
	22'	4" Cast Iron pipe			8-20-60			
						10'	6" Transite	
						1	6" Clay Elbow	

1.18501

DATE _____

TOWN OF LEXINGTON — BOARD OF PUBLIC WORKS

SEWER DIVISION

Sketch of Service Here 38

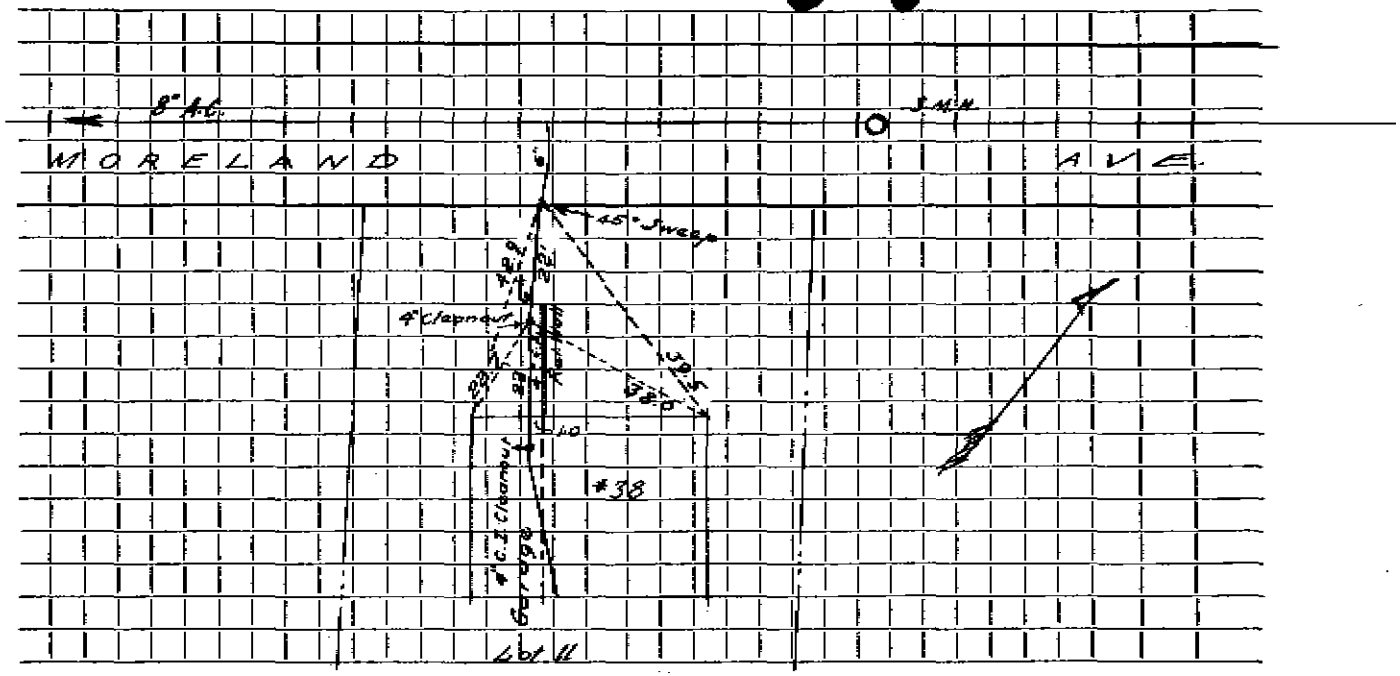

Connection made in ..... Street. Work completed .....

Remarks: .....

.....

.....