Name Philip Heidke Realty Trust **Service No.** 73

Address 5 MORRIS ST LOT 90-24 (OPP #4) VACANT

5 Morris ST. **Location**

Kind of Pipe AC **Size** 6" **Size of Main** 8"

~~[illegible]~~ **New Service** Dave Eagle #3350 **Location** NOV 13 1978

Date		Material	Amount		Total		Date			Amount	
~~July 18~~	~~75~~	~~17' 6" AC~~	~~$10~~	~~00~~	~~$170~~	~~00~~	~~11-14-78~~		Deposit	170	00
2/7/79	40'	6" Transite pipe									
	10'	4" Cast iron pipe					7-18-75				
								17'	6" Transite		
								1	6" X 8" Wye		

B.N.18601

DATE _____

TOWN OF LEXINGTON — BOARD OF PUBLIC WORKS

SEWER DIVISION

Sketch of Service Here 5

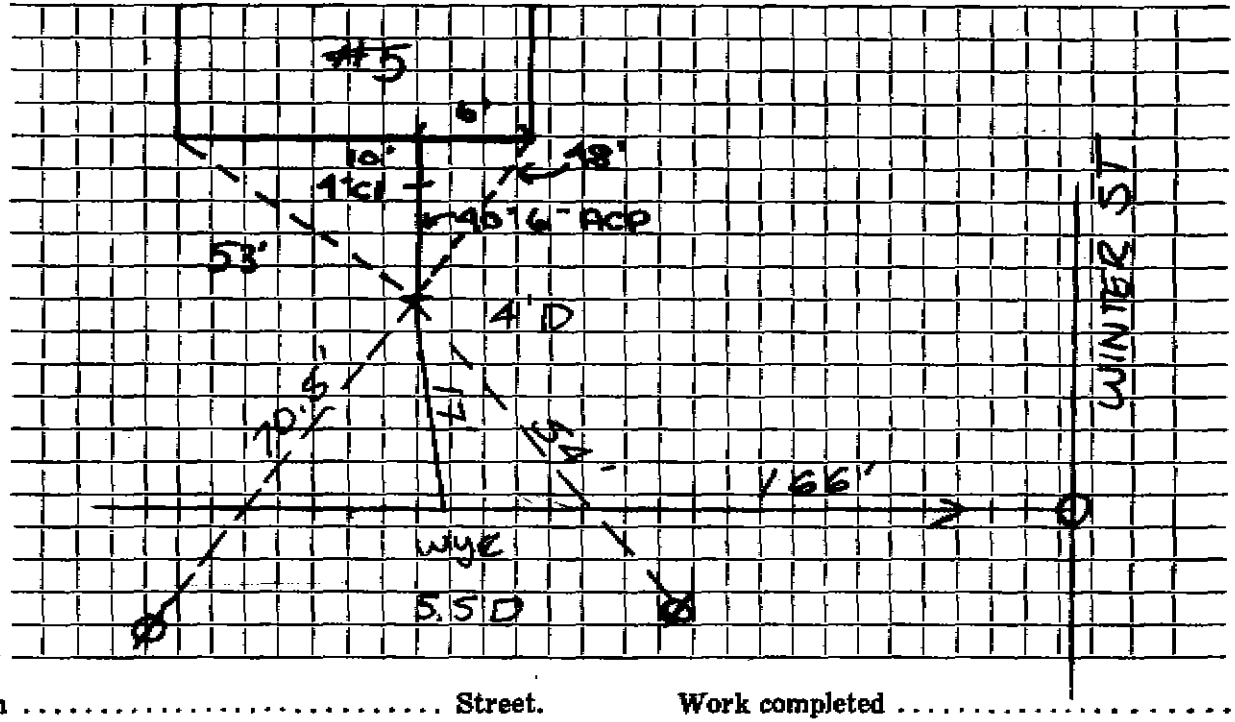

Connection made in ..... Street. Work completed .....

Remarks: .....

.....

.....