Name William J. Ingant — Service No. 193

Address 2 Munroe Rd.

2 Munroe Rd. — Location 2 Munroe Road

Kind of Pipe — Size 6" — Size of Main 8"

Repair—Renewal—New Service WO# 8328 — Location Comm 8-18-64

Date		Material	Amount	Total	Date		Amount
0-64		Labor 56.05			11-19-63	Deposit	300 00
-64		" 15.69	71.74		5-18-64	Refund	51 60
		10% O.H.	7.17	78.91	12-10-64		248 40
	30'	6" Transite pipe @82		24.60		16.3' 6" Transite	
	1	22½° Transite Bend		4.09		1 6"-45° Bend	
	5	yds - Loam @3.00		15.00		1 6"x8" Wye	
	4	hrs - Trucking @3.00		12.00			
	1	hr - Trailer @3.00		3.00			
	2	hrs - Tom Shovel @6.50		13.00			
		Previous Charge		97.80		16.3 feet 6" A.C.	
				248.40		installed by contractor	
						@ 6.00 per foot	97 80

501

DATE _____

TOWN OF LEXINGTON — BOARD OF PUBLIC WORKS

SEWER DIVISION

Sketch of Service Here **2**

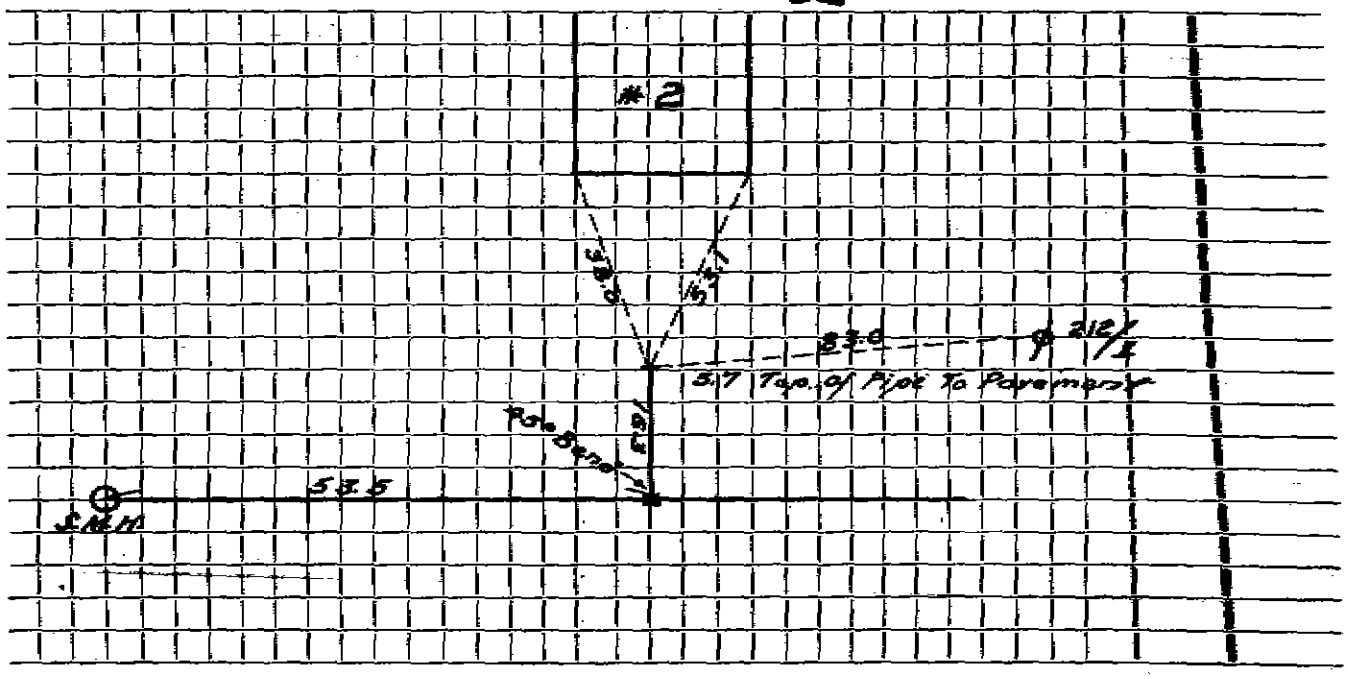

Connection made in ..... Street. Work completed .....

Remarks: .....

.....

.....