Name Charles V. Campbell **Service No.** 95

Address 60 Monroe Road

60 Monroe Rd. **Location**

Kind of Pipe **Size** 6" **Size of Main** 8"

[redacted] **New Service** Lexington Sewerage permit # 2094 **Location** AUG 14 1972

Date		Material	Amount	Total	Date			Amount
~~5~~	22'	~~6" Transite pipe~~ @5.00		110.00	~~6-22-65~~		Deposit	110.00
					3-6-	65		
						22'	6" Transite	
'72	45'	6" Transite				1	6"X8" Wye	
	4'	4" Cast Iron						

0501

DATE _____

TOWN OF LEXINGTON — BOARD OF PUBLIC WORKS

SEWER DIVISION

Sketch of Service Here 60

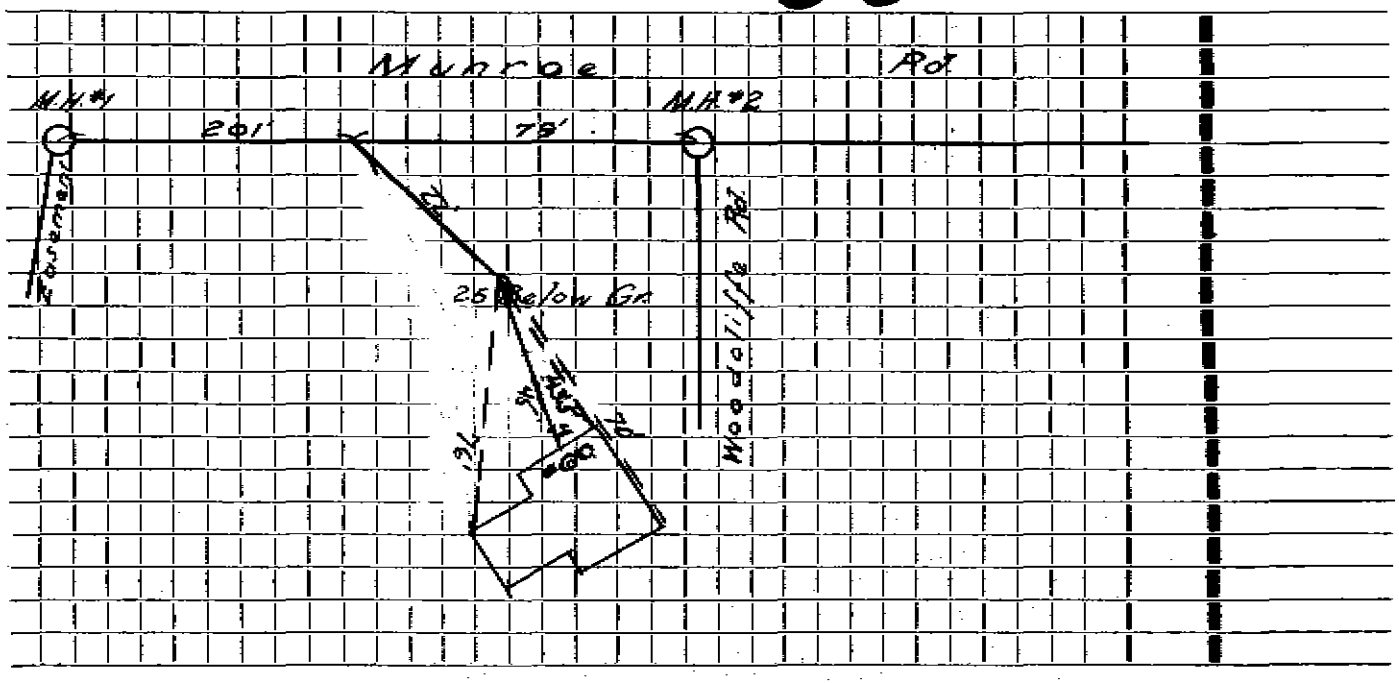

Connection made in ..... Street. Work completed .....

Remarks: .....

.....

.....