Name

Service No. 2299

Address 3 Myrna RD

Location

Kind of Pipe PVC + AC Size 6" Size of Main 8"

Repair—Renewal—New Service J McLaughlin Location

Date		Material	Amount	Total	Date		Amount
11/9/06	6'	4" Sch 40					
	29.6	6" PVC					
	1	4x6 Ferrco					
	1	6" A.C. x 6" PVC Ferrco					
	INV-	8'.0 DWN					
8/27/73		Exist					
	29'0	A.C.					
	1	8x6 Wye					

DATE _____

TOWN OF LEXINGTON — BOARD OF PUBLIC WORKS

SEWER DIVISION

Sketch of Service Here

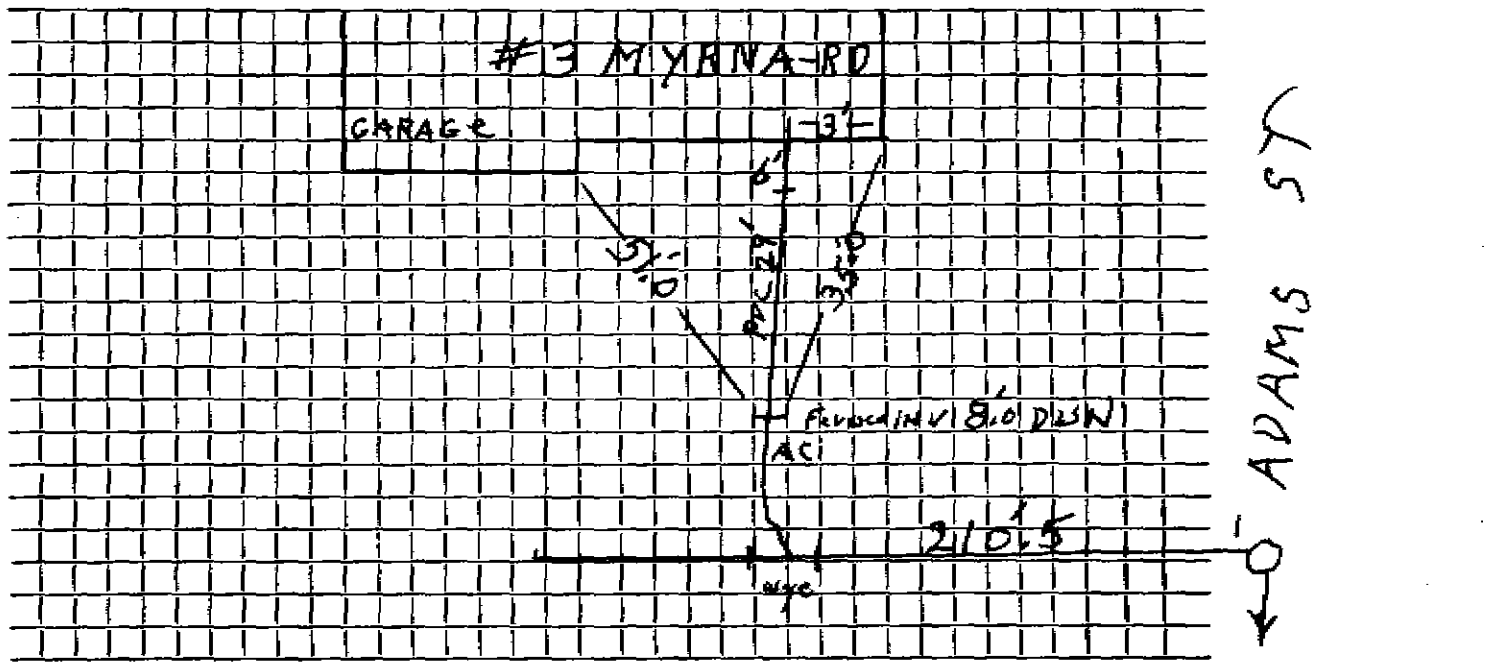

Connection made in ..... Street. Work completed 11/9/06 J. McLaughlin

Remarks: .....

.....

.....