Name Tricorn Homes **Service No.** 141

Address 20 Nichols Road

20 Nichols Rd. **Location**

Kind of Pipe **Size** 6" **Size of Main** 8"

Repair—Renewal—New Service Russell Sibley - Permit #947 **Location** AUG 5 1968

Date		Material	Amount		Total		Date			Amount	
		Previous Charge			$ 135	00	10-3-67		Deposit	135	00
1-20-67	41'	6" Transite pipe									
							11-24-75		Solids		

3.M.18501

DATE _____

TOWN OF LEXINGTON — BOARD OF PUBLIC WORKS

SEWER DIVISION

Sketch of Service Here **20**

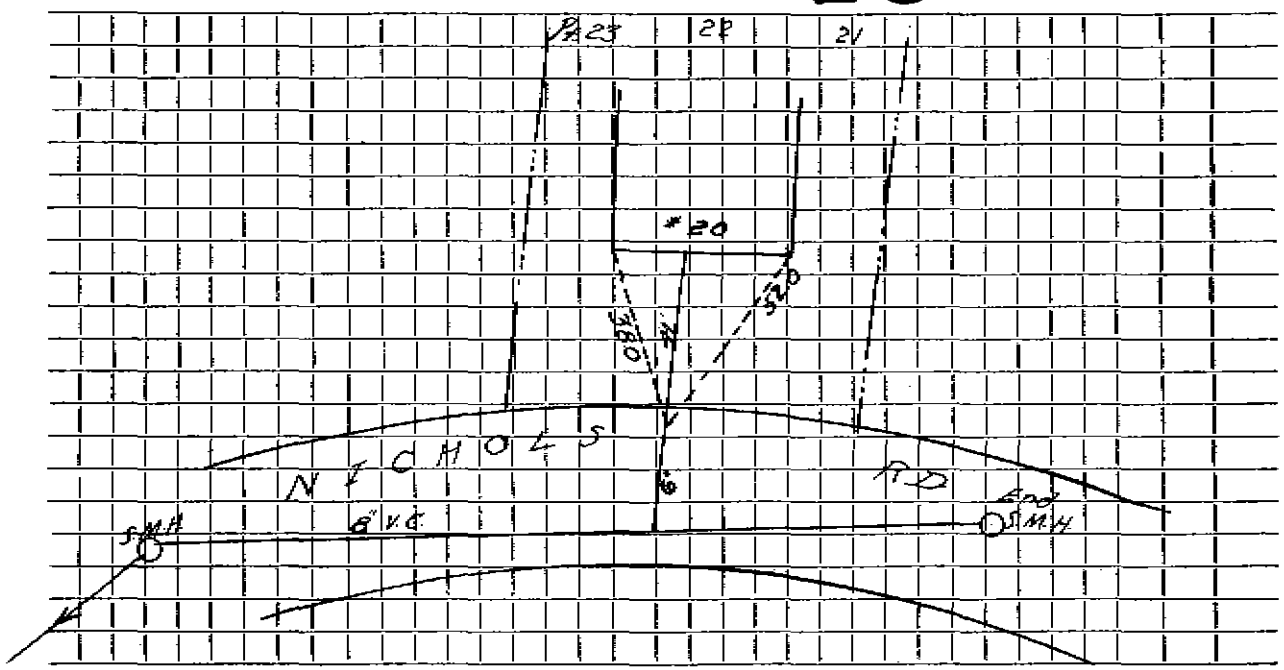

Connection made in ..... Street. Work completed .....

Remarks: .....

.....

.....