Name Jenkins Realty **Service No.**

Address 16 Nickerson Road

Lot #7 16 Nickerson Rd. **Location**

Kind of Pipe **Size** 6" **Size of Main** 8"

Repair—Renewal—New Service DeFlice #1480 Lucente #631 **Location**

Date		Material	Amount	Total	Date			Amount
7/67	30'	6" Transite pipe						
-10-69	42'	6" Transite pipe			6-17-67			
	10'	4" Cast Iron pipe				30'	6" Transite	
						1	6" x 8" Wye	

.N.18501

DATE _____

TOWN OF LEXINGTON — BOARD OF PUBLIC WORKS

SEWER DIVISION

Sketch of Service Here 16

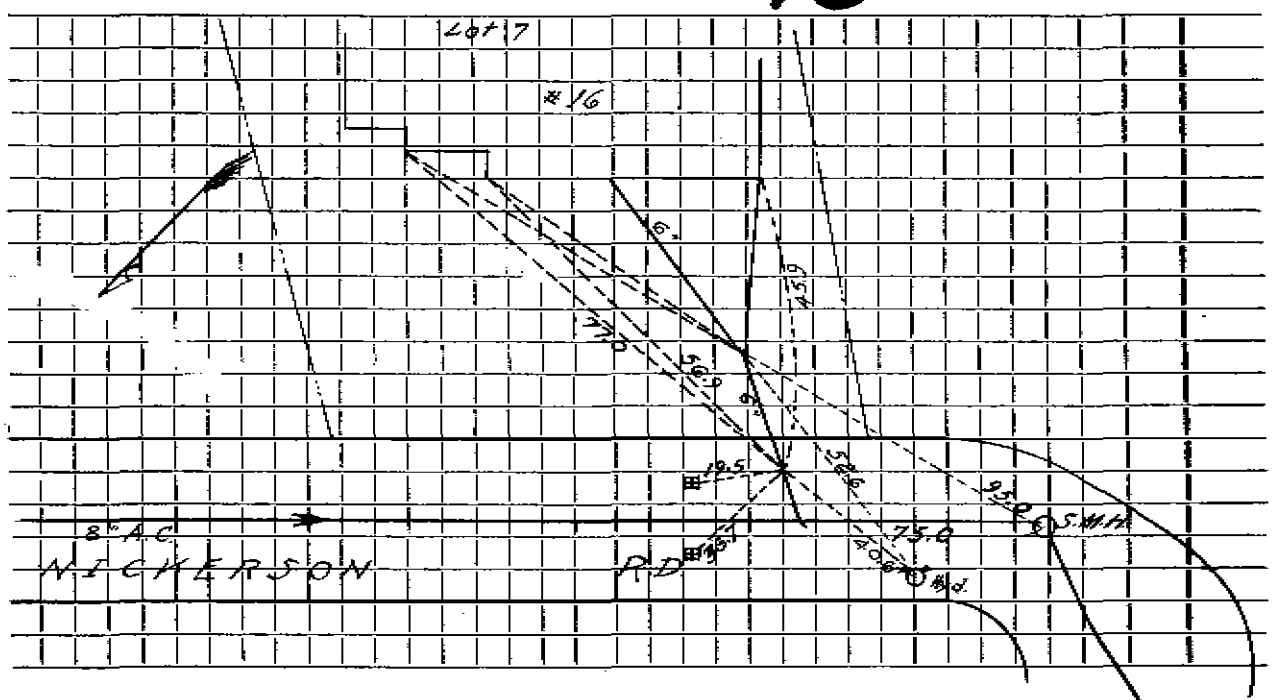

Connection made in ..... Street. Work completed .....

Remarks: .....

.....

.....