Name Jack Eddison **Service No.**

Address 20 Nickerson Road

20 Nickerson Rd. **Location** Lot #5

Kind of Pipe **Size** 6" **Size of Main** 8"

Repair—Renewal—New Service D & F Trucking #3625 - Renewal Lucente - Permit #633 **Location**

Date		Material	Amount	Total	Date			Amount
~~43/67~~	~~42'~~	~~6" Transite~~						
29/83	31'	6" P.V.C.			6-13-67			
		6" Fernco Adpt.				42'	6" Transite	
		4" x 6" Donut				1	6" X 8" Wye	

B.X.18501

DATE _____

TOWN OF LEXINGTON — BOARD OF PUBLIC WORKS

SEWER DIVISION

Sketch of Service Here

20

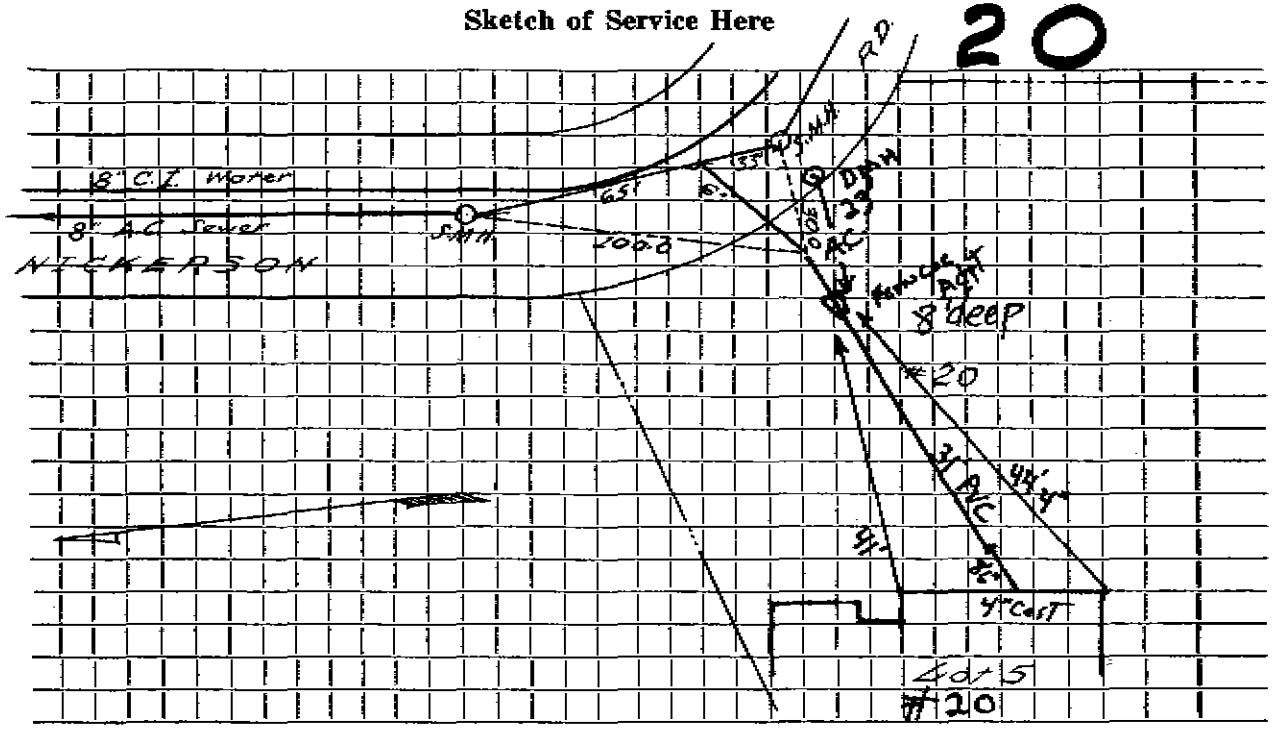

Connection made in ..... Street. Work completed .....

Remarks: Water is in with Sewer