Name Jenkins Realty, Inc. **Service No.**

Address 26 Nickerson Road

26 Nickerson Rd. **Location**

Kind of Pipe **Size** 6" **Size of Main** 8"

~~Repair~~ ~~Renewal~~ **New Service** DeFelice Brothers Cont. Permit #1257 **Location**

Date		Material	Amount	Total	Date		Amount
11/18/68	60'	6" Transite pipe					
	10'	4" Cast Iron pipe					
2-17-68	17'	6" Transite pipe					
	20'	4" Cast Iron pipe					
					2-22-77	Solids	

.N.10501

DATE _____

TOWN OF LEXINGTON — BOARD OF PUBLIC WORKS

SEWER DIVISION

Sketch of Service Here **26**

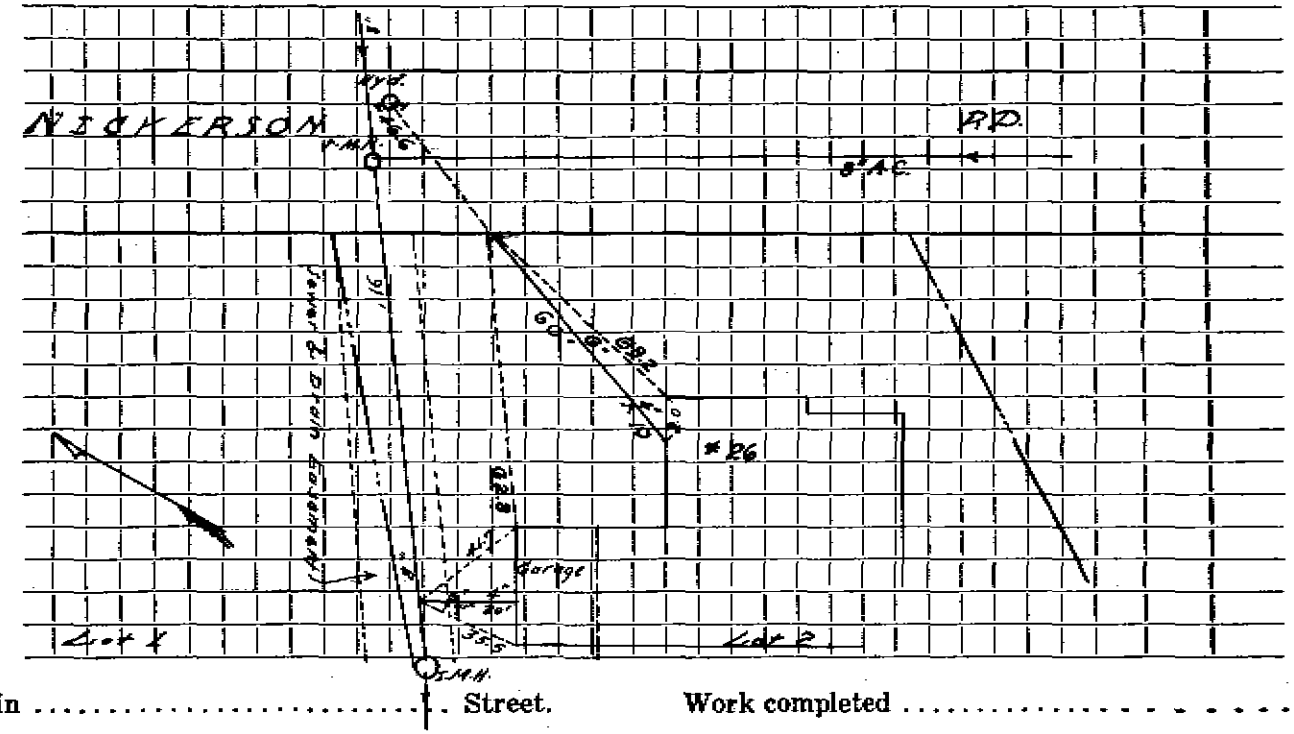

Connection made in ..... Street. Work completed .....

Remarks: .....

.....

.....