Name Jenkins Realty **Service No.**

Address 4 Nickerson Road

4 Nickerson Rd. **Location** ~~Lot #12~~

Kind of Pipe **Size** 6" **Size of Main** 8"

Repair—Renewal—New Service J.M. Lucente Co. - Permit # 622 **Location**

Date		Material	Amount		Total		Date			Amount	
~~29/67~~	~~33'~~	~~6" Transite~~									
							6-29-	67			
								33'	6" Transite		

J.M.18501

DATE _____

TOWN OF LEXINGTON — BOARD OF PUBLIC WORKS

SEWER DIVISION

Sketch of Service Here 4

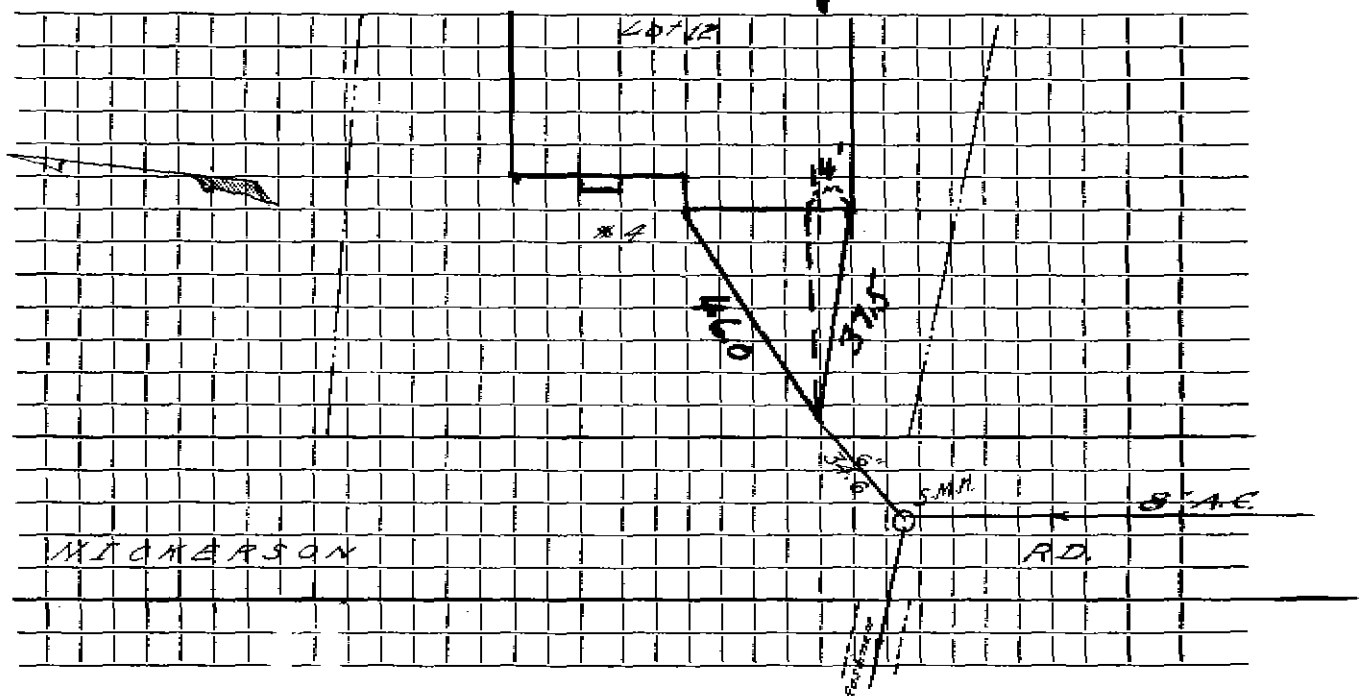

Connection made in ..... Street. Work completed .....

Remarks: .....

.....

.....