Name Jenkins Realty

Service No.

Address 6 Nickerson Road

6 Nickerson Rd.

Location Lot #11

Kind of Pipe

Size 6"

Size of Main 8"

Repair—Renewal—New Service

DeFlice Bros. #1716
Lucente - Permit #624

Location

Date		Material	Amount	Total	Date			Amount
~~7/67~~	~~30'~~	~~6" Transite~~						
1-70	51'	6" Transite			6-17-67			
	10'	4" Cast Iron pipe				30'	6" Transite	
						1	6" X 8" Wye	

K.18501

DATE _____

TOWN OF LEXINGTON — BOARD OF PUBLIC WORKS

SEWER DIVISION

Sketch of Service Here 6

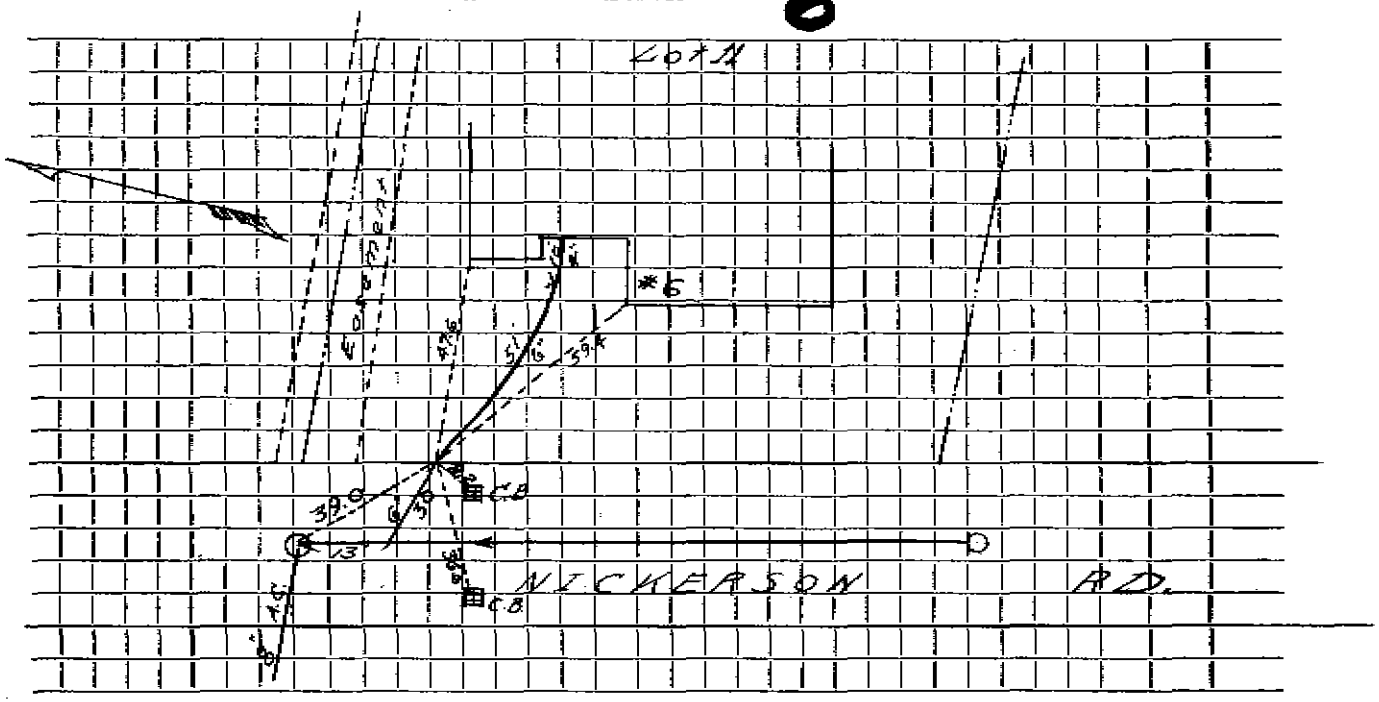

Connection made in ..... Street. Work completed .....

Remarks: .....

.....

.....