Name | Service No.

Address 17 Normandy Rd

Location

Kind of Pipe | Size | Size of Main

Repair—Renewal—New Service | Location

Date	Material	Amount	Total	Date		Amount
Sept 20, 1999	10' - 4" PVC			2-15-65	20' 6" Transite	
	26' - 6" PVC				1 - 6x8 WYE	
	1 - 4"x6" Fernco					
	1 - 6"x6" AC to PVC Fenco					

DATE _____

TOWN OF LEXINGTON — BOARD OF PUBLIC WORKS

SEWER DIVISION

Sketch of Service Here

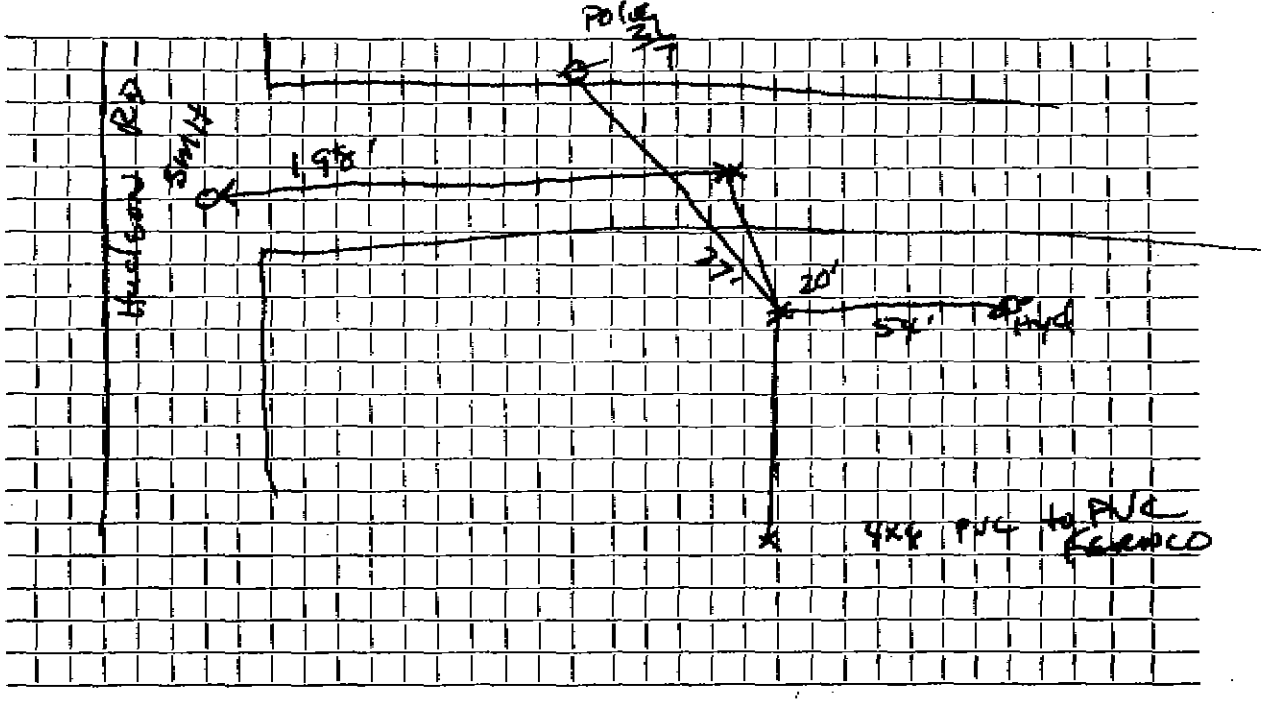

Connection made in ..... Street. Work completed .....

Remarks: House torn down - new service put out to property line

.....

.....