Name **Service No.**

Address 42 Normandy Rd

Location PG. 25 - Lot 57

Kind of Pipe PVC + AC **Size** 6" **Size of Main** 8"

Repair—Renewal—New Service **Location**

Date		Material	Amount	Total	Date		Amount
12/9/11	10'	4" - Sch 40					
	1	4 x 6 - Fernco					
	1	6" Cleanout					
	36'	6" PVC					
	1	6" - PVC x AC. Fernco	4 - 5' Down				
		Existing					
2/16/65	1	8 x 6 - Wye					
	22'	6" - Transite					

DATE_____

TOWN OF LEXINGTON — BOARD OF PUBLIC WORKS

SEWER DIVISION

Sketch of Service Here

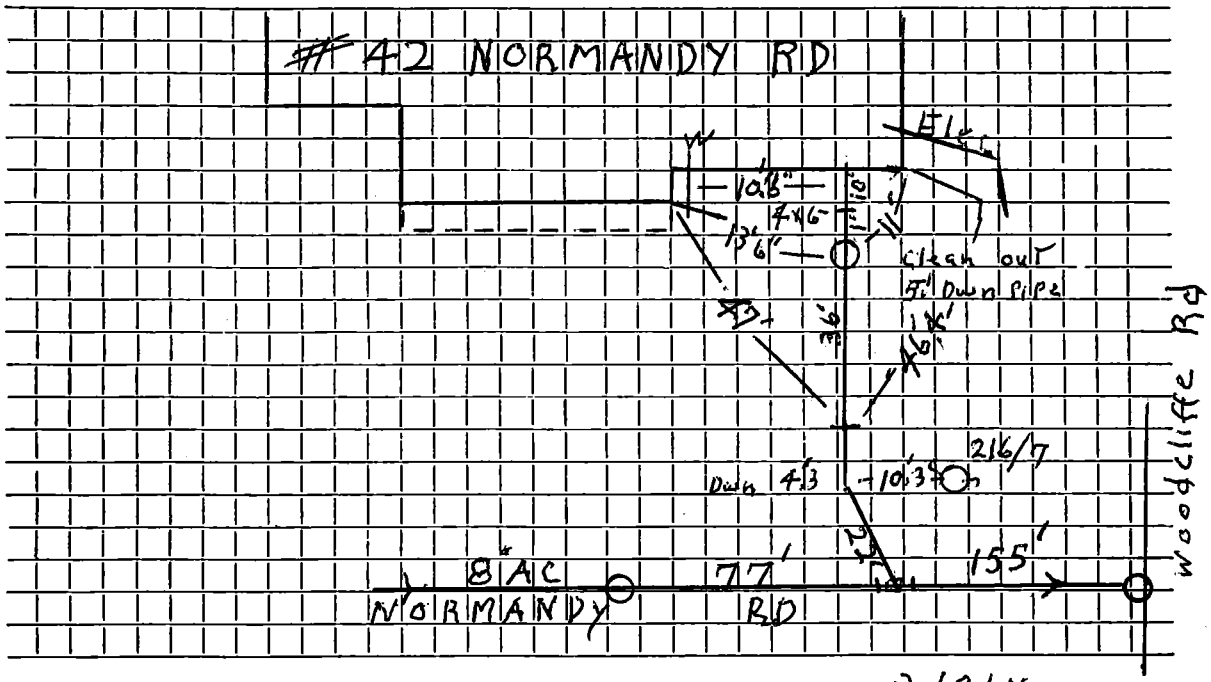

Connection made in ..... Street. Work completed 2/9/11

Remarks: .....

.....

....