Name Egil Straujups **Service No.** 23

Address 126 North Street

126 NorTh ST. **Location**

Kind of Pipe **Size** 6" **Size of Main** 8"

~~Repair/Renewal~~ New Service McLaughlin #4579 **Location** SEP 5 1986

Date		Material	Amount		Total		Date			Amount	
~~Aug. 1986~~	~~95' of 6" DEP @~~	$14.00			350.	00	8-6-86		Deposit	350	00
8/7/86	47'	6" P.V.C.									
	6'	4" P.V.C.					8-	-	80		
	2	22° Bends						25'	6" Transite		
	1	4" x 6" Fernco									
	1	6" x 6" Fernco									

DATE _____

TOWN OF LEXINGTON — BOARD OF PUBLIC WORKS

SEWER DIVISION

Sketch of Service Here 126

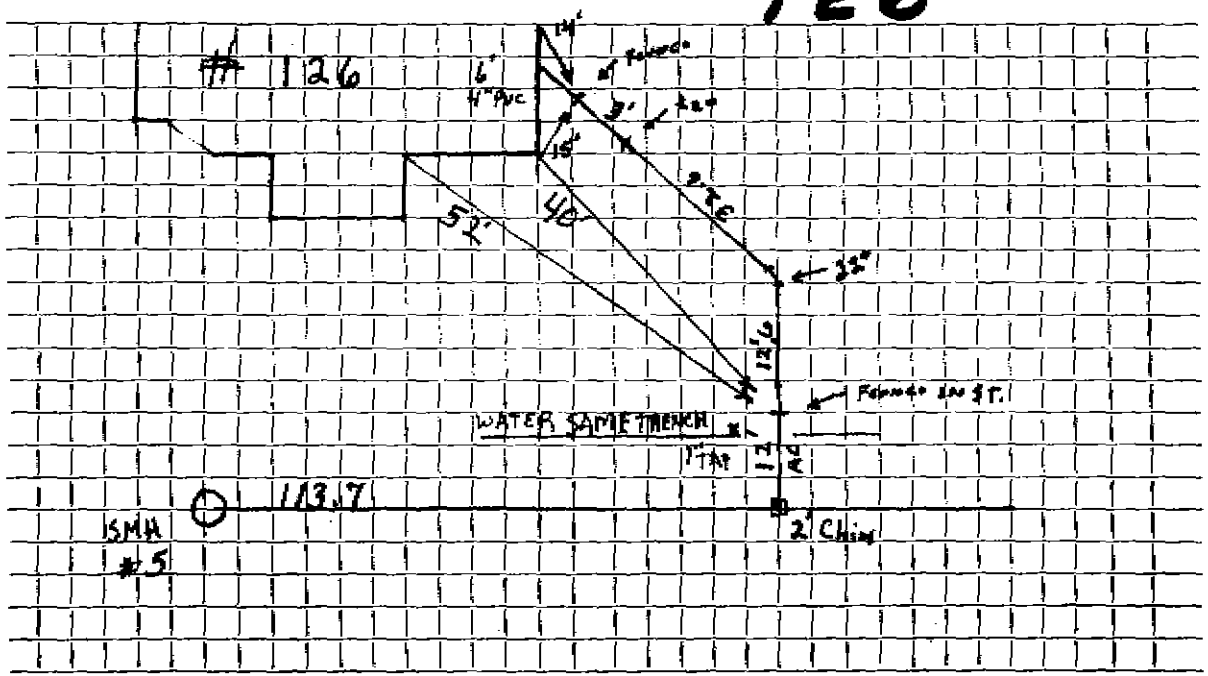

Connection made in ..... Street. Work completed .....

Remarks: "Removed 13' AC. Pitching wrong way"