Name **Service No.**

Address 127 NORTH ST

Location

Kind of Pipe SDR35 PVC **Size** 6" **Size of Main**

Repair—~~Renewal~~—New Service **Location**

Date		Material	Amount		Total		Date			Amount	
6/8/23		6" PVC									
		6" Cleanout	1								
		6" Fernco	1								

DATE 6/8/2023

TOWN OF LEXINGTON — BOARD OF PUBLIC WORKS

SEWER DIVISION

Sketch of Service Here

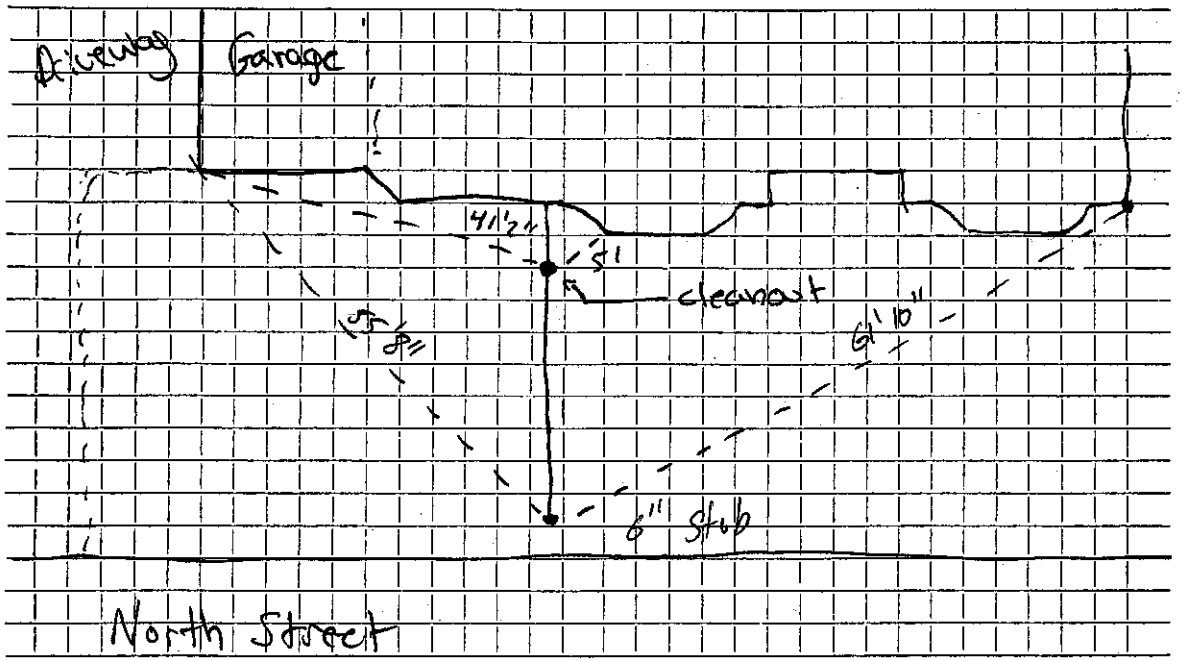

Connection made in 127 North Street Street. Work completed .....

Remarks: INSTALLED BY SEAN FARRELL EXCAVATING