Name

Service No.

Address Vacant Lot #1 North St. (opposite hse # 126)

Location

Kind of Pipe ACP

Size 6"

Size of Main 8"

Repair—Renewal—New Service

Location

Date	Material	Amount	Total	Date		Amount
Aug/80	17' of 6" ACP @ $14.00/ft =		238.00			

DATE _____

TOWN OF LEXINGTON — BOARD OF PUBLIC WORKS

SEWER DIVISION

Sketch of Service Here

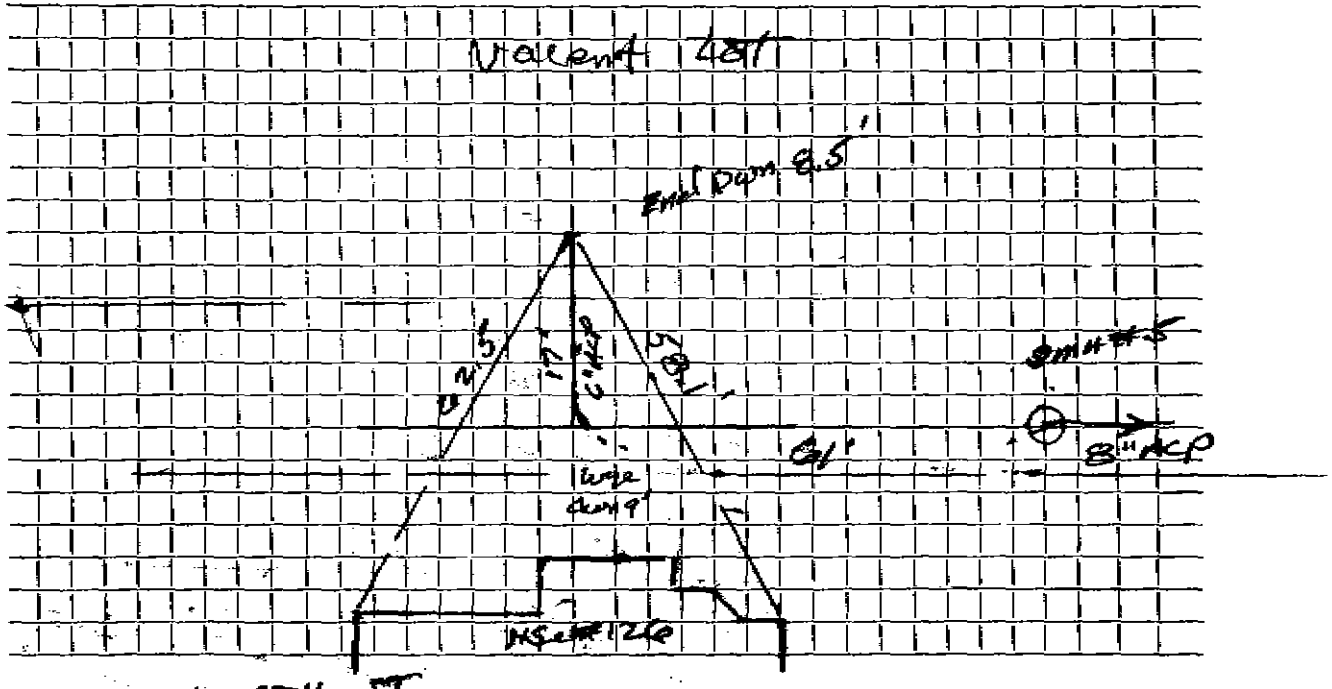

Connection made in .....NORTH ST..... Street. Work completed .....

Remarks: .....

.....

.....