Name **Service No.**

Address Vacant Lot #4 (across from Hse. #139)

Location

Kind of Pipe ACP **Size** 6" **Size of Main** 8"

Repair—Renewal—New Service **Location**

Date	Material	Amount	Total	Date		Amount
AUG/80	22' of 6" ACP @	14.00/ft. =	$308.00			

DATE _____

TOWN OF LEXINGTON — BOARD OF PUBLIC WORKS

SEWER DIVISION

Sketch of Service Here

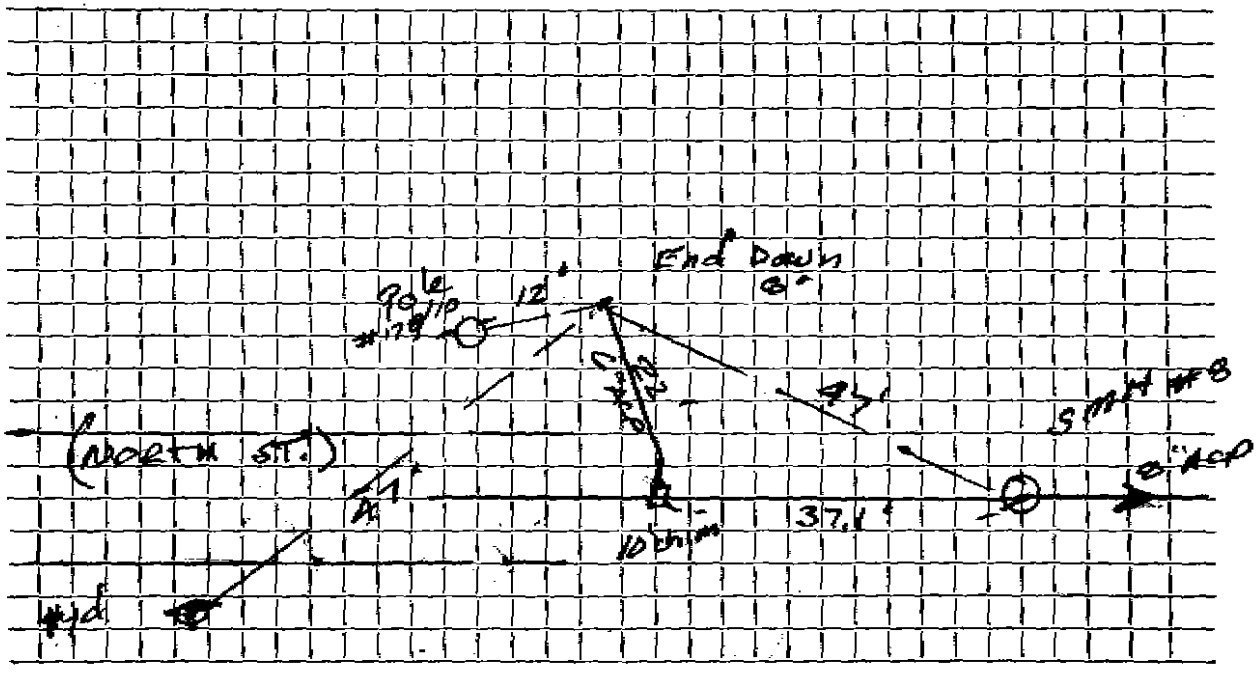

Connection made in NORTH Street. Work completed .....

Remarks: .....