Name | Service No.

Address 30 Oak St

Location

Kind of Pipe | Size | Size of Main

Repair—Renewal—New Service | Location

Date	Material	Amount	Total	Date		Amount
4-4-06	10' 4" PVC					
	4x6 PVC to PVC Fernco					
	6x6x6 wye clean-out					
	48' - 6" PVC					
	6x6 clay to PVC Fernco					

DATE _____

TOWN OF LEXINGTON — BOARD OF PUBLIC WORKS

SEWER DIVISION

Sketch of Service Here

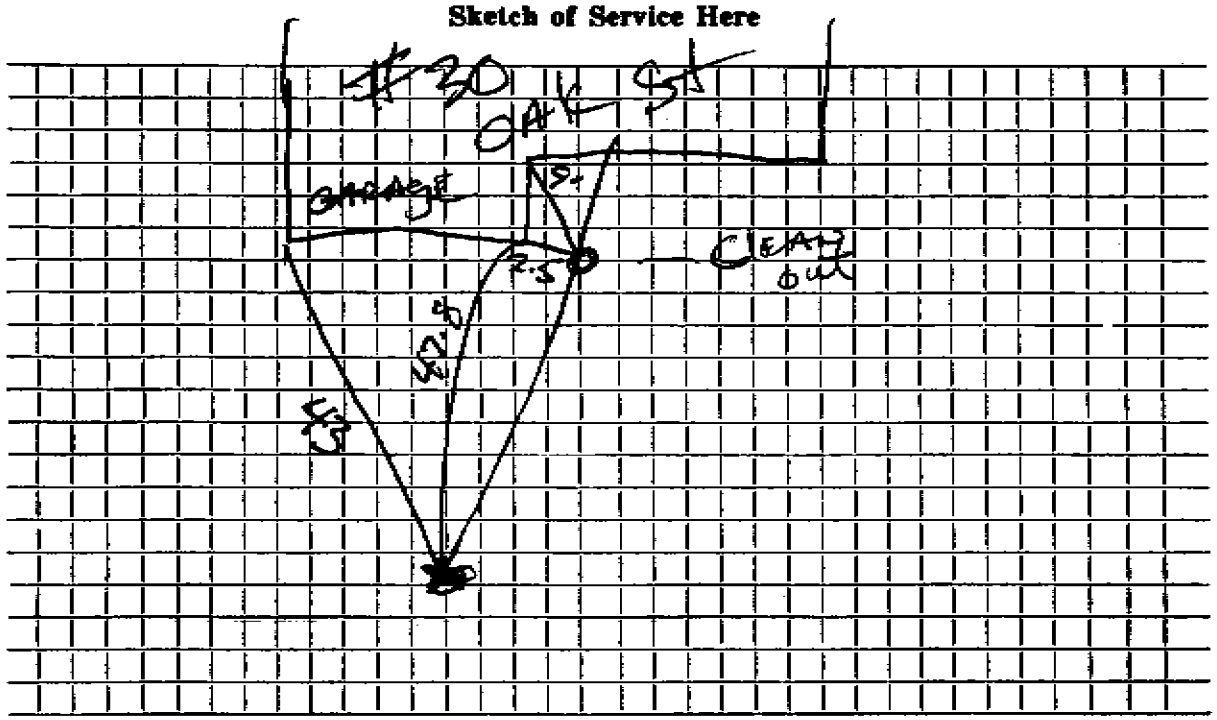

Connection made in ..... **Street.** **Work completed** .....

Remarks: .....

.....

.....