Name PETER GARTMAN **Service No.**

Address #28 OAKMONT CIRCLE

28 OaKmounT Circle **Location**

Kind of Pipe **Size** 6" **Size of Main** 8"

Repair—Renewal—New Service PERMIT NO. 0475 McLaughlin **Location**

Date	Material	Amount	Total	Date			Amount
1985	413' - 6" PVC						
				9-2-	80		
					40'	6" Transite	
					1	6" X 8" Wye	

DATE 15 JUNE 1995

TOWN OF LEXINGTON — BOARD OF PUBLIC WORKS

SEWER DIVISION

Sketch of Service Here 28

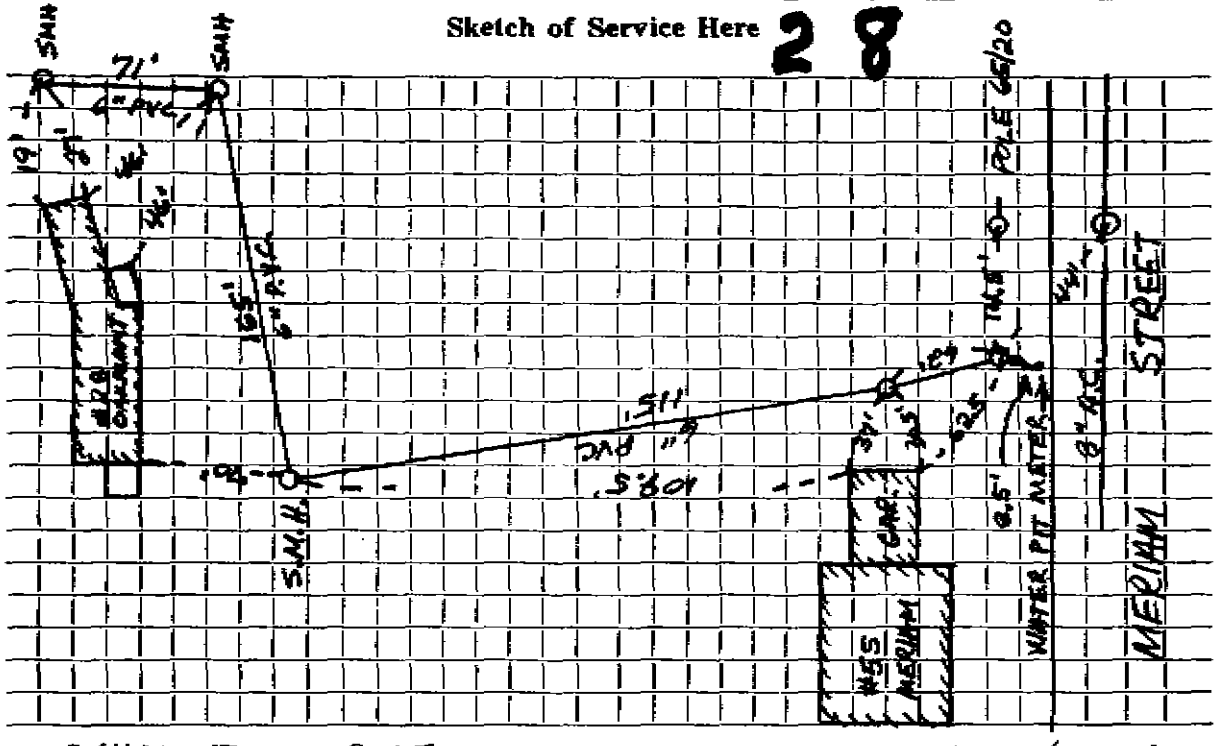

Connection made in OAKMONT CIRCLE Street. Work completed J.M. MCLAUGHLIN

Remarks:

BOOK 96A

J.W.