PERMIT # 713

Name

Service No.

Address 8 OAKMONT CIRCLE

INSP. BY: P.G. HIGGINS

Location INSP. N.B. S+W. #95-2 Pg 15

Kind of Pipe SEWER (PVC) Size 4"/6" Size of Main

Repair—Renewal—New Service DONE BY: MACONE BROTHERS Location

Date	Material	Amount	Total	Date		Amount
11/2/95						
	13' OF 4" PVC					
	112' OF 6" PVC					
	2-SMALL S.M.H.					

DATE 11/4/95

TOWN OF LEXINGTON — BOARD OF PUBLIC WORKS

Sketch of Service and

(15)

#8 OAKMONT CIRCLE @ REAR BLDG

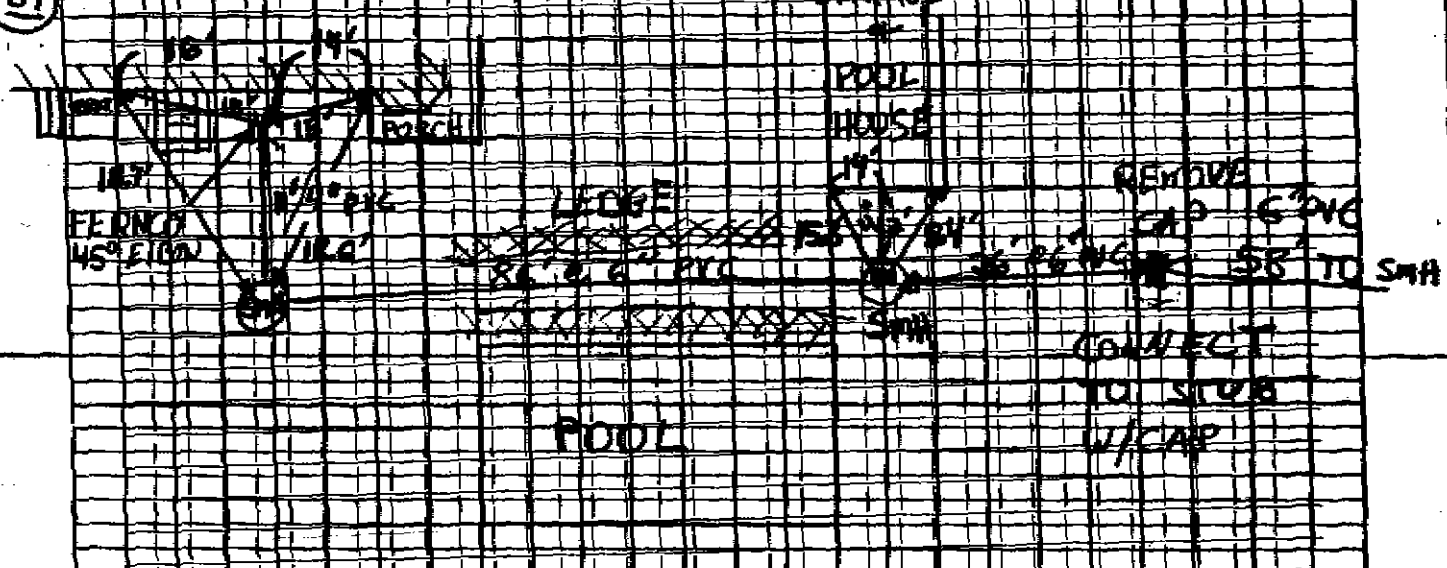

Work made in ..... Street. Work completed .....