Name Easement between #359 & 361 **Service No.**

Address off Emerson Rd Lot 27

4 Services **Location**

Kind of Pipe **Size** **Size of Main**

Repair—Renewal—New Service **Location**

Date	Material	Amount	Total	Date		Amount
	No Charge					
	No Charge					

18501

DATE _____

TOWN OF LEXINGTON — BOARD OF PUBLIC WORKS

SEWER DIVISION

Sketch of Service Here

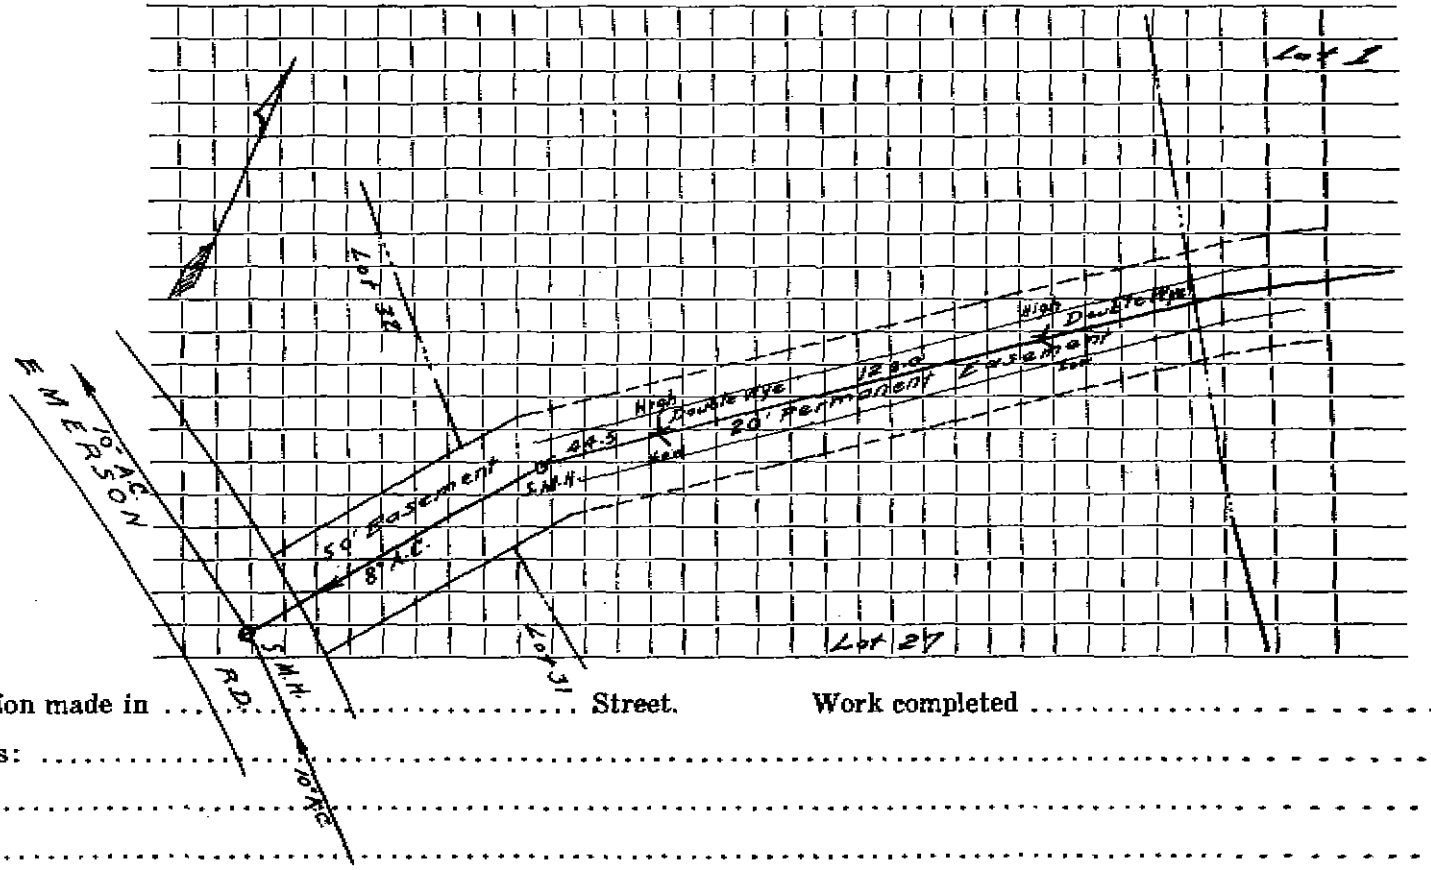

Connection made in ..... Street. Work completed .....

Remarks: .....

.....

.....