Name

Service No.

Address 154 OLD SPRING STREET

Location

Kind of Pipe PVC

Size 6"

Size of Main 8" PVC

Repair—Renewal—New Service

Location

Date	Material	Amount	Total	Date		Amount
12-8-97	15 LF 6" PVC	$40.00	$600.00			

DATE 3-18-98

TOWN OF LEXINGTON — BOARD OF PUBLIC WORKS

SEWER DIVISION

Sketch of Service Here

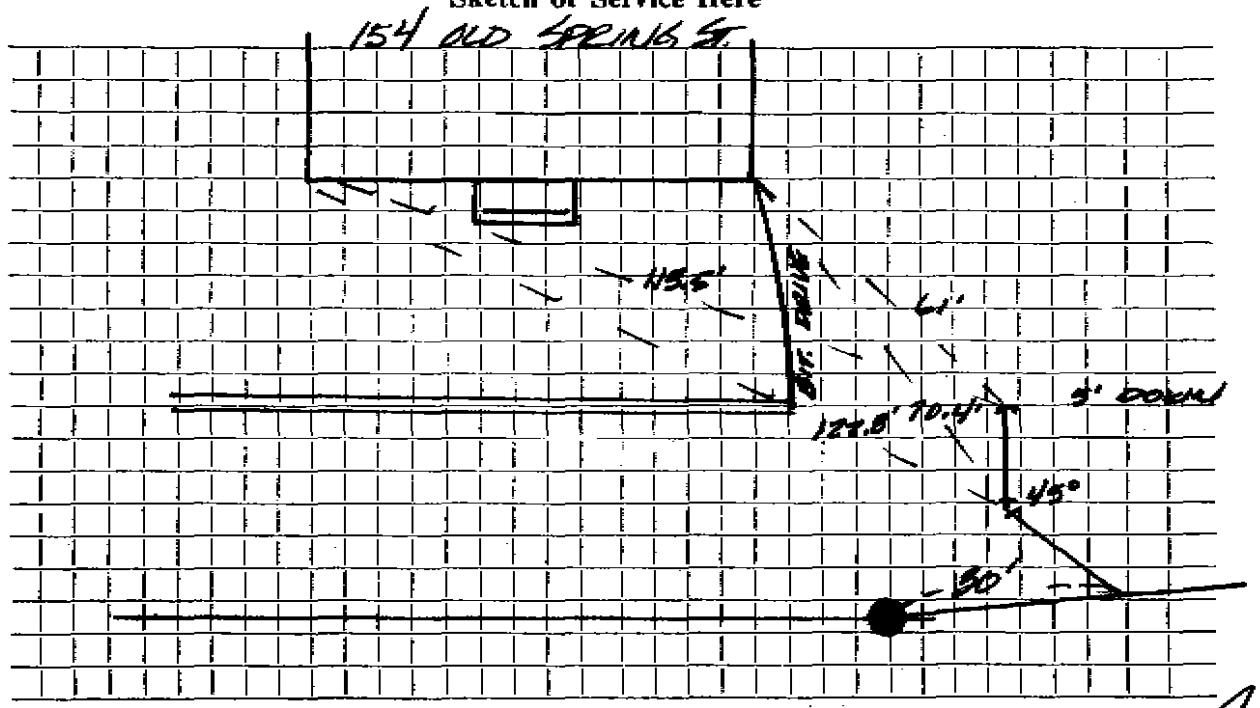

Connection made in Old Spring Street. Work completed Contract 97-4

Remarks: