Name Harvey Smith **Service No.** 153

Address 36 Outlook Drive

36 Outlook Drive **Location**

Kind of Pipe **Size** 6" **Size of Main** 8"

~~Repair~~ ~~Renewal~~ x New Service COM. 9-6-55 **Location**

Date	Material	Amount	Total	Date		Amount
7/23/55	Labor	37 16		7-22-55	Deposited	175 00
	10% overhead	3 72	40 88	9-6-55	Refunded*	(60 41)
	42'-6" sewer pipe @.32		13 44			114 59
	joint compound		2 52			
	12' x 3' patching		12 00			
	6 hrs. Littlefield shovel@7.50		45 00			
	1 hr. trucking@.75		75			
			114 59			
				$22.15 of this refund		
				made payable to Town		
	Labor			to apply on bal due on		
				M.H.E. #284		

TOWN OF LEXINGTON—DEPT. OF PUBLIC WORKS

SEWER DIVISION

DATE ..... NO. .....

The undersigned applies for the construction of a particular sewer connecting No. ..... Street and hereby agrees to comply with the Rules and Regulations governing the construction and use of Particular Sewers, as now or at any future time established by the Board of Selectmen.

Am't of estimate $.....

Am't Paid $.....

..... Owner

Sketch of Service Here

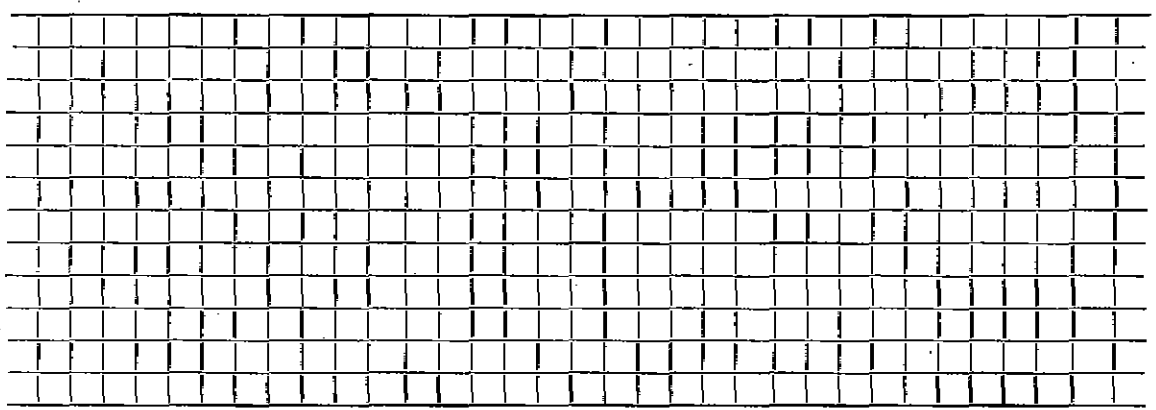

Connection made in ..... Street. Work completed ..... 19..

Remarks: