Name PAUL JOSEPH. **Service No.**

Address 38 OUTLOOK DRIVE

Location

Kind of Pipe P.V.C. **Size** **Size of Main**

Repair—Renewal—New Service – PERMIT NO 1097 **Location**

Date		Material	Amount		Total		Date			Amount	
JUNE 3	98	4' 4" P.V.C									
"		65' 6" P.V.C									
"		1 4"x6" FERNCO									
		PERMIT FEE PAID	$ 100	00							

DATE JUNE 3 1998

TOWN OF LEXINGTON — BOARD OF PUBLIC WORKS

SEWER DIVISION

Sketch of Service Here

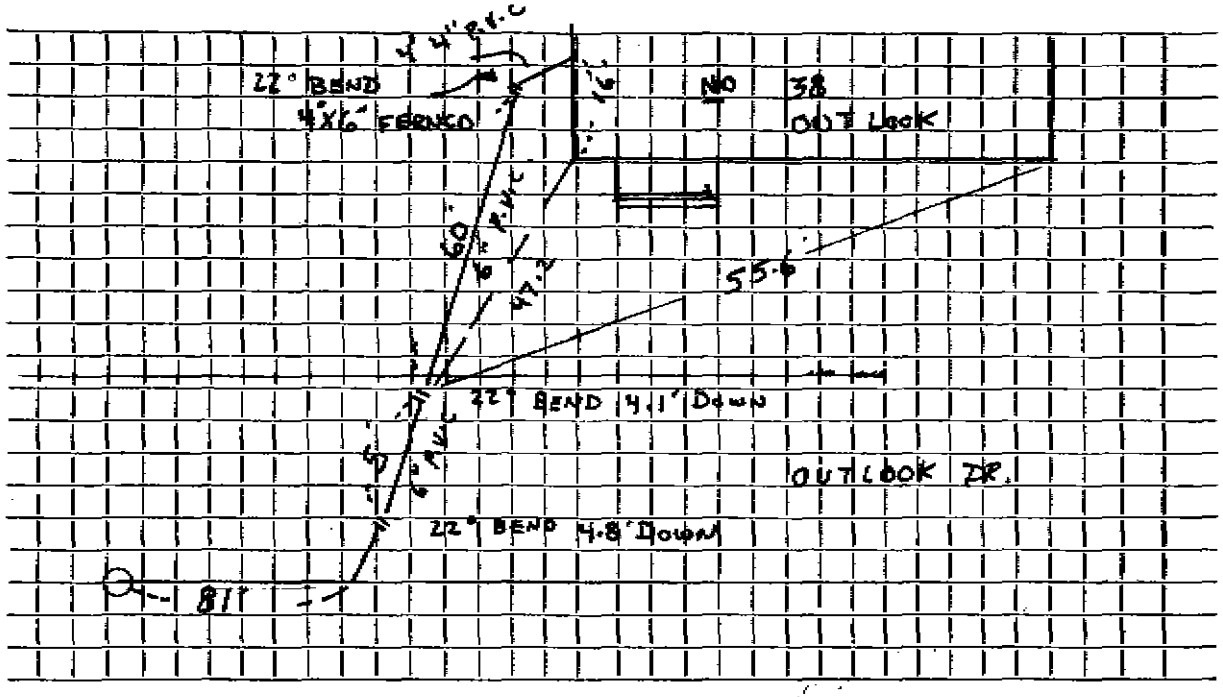

Connection made in OUTLOOK DRIVE ..... Street. Work completed BRUCE MCKEE .....

Remarks: .....

.....

.....