Name Bruce Dalwin **Service No.**

Address 97 Outlook Drive

97 OuTlooK Drive **Location** Lot 140 & Pt. 139

Kind of Pipe **Size** 6" **Size of Main** 8"

Repair—Renewal—New Service E.R. Banks #4823 **Location**

Date		Material	Amount	Total	Date			Amount
1971	~~20'~~	~~6" A.C. transite pipe~~ @7.50		150.00	6-28-89		Deposit	150 00
6/28/89	58'	6" PVC				1971		
	1	4 x 6 CI to PVC Ferrco				20'	6" Transite	
	2	22° Bends						
	1	6 x 6 PVC to AC Ferrco						

DATE _____

TOWN OF LEXINGTON — BOARD OF PUBLIC WORKS

SEWER DIVISION

Sketch of Service Here 97

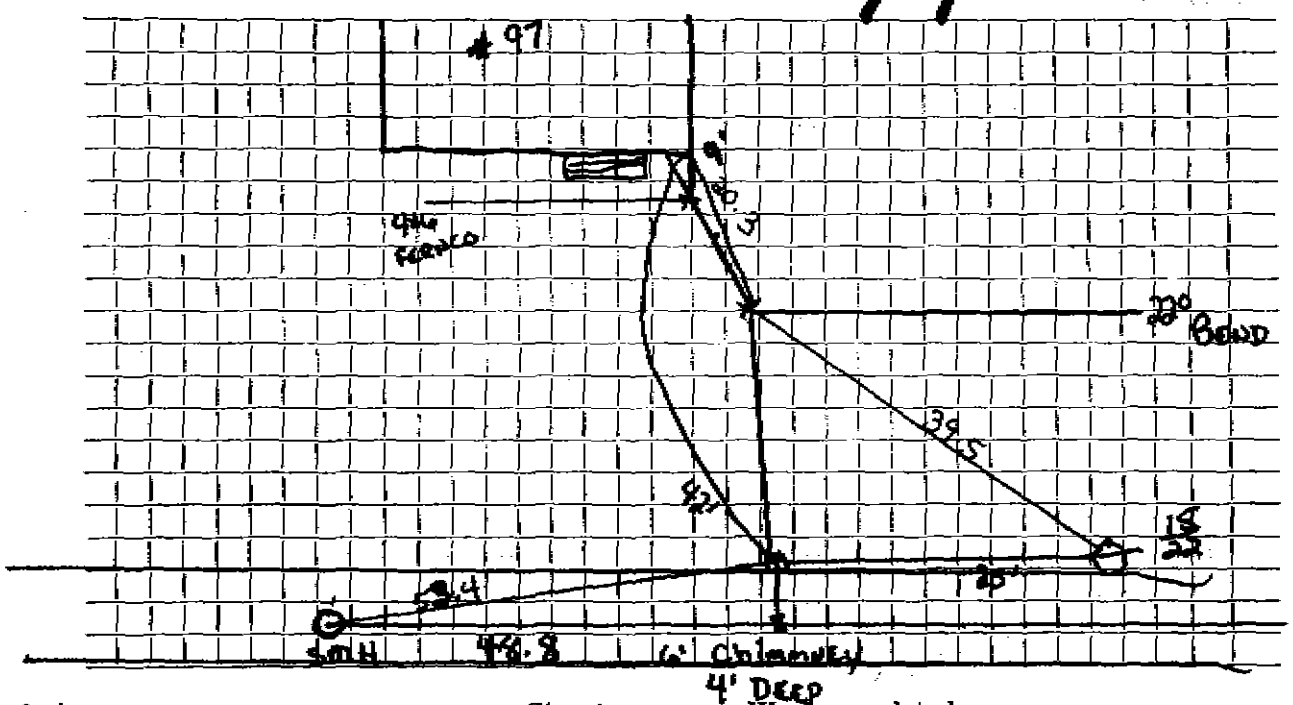

Connection made in ..... Street. Work completed .....

Remarks: .....

.....