Name **Service No.**

Address 4 Paddock Lane

4 Paddock Lane **Location** Lot#2

Kind of Pipe **Size** 6" **Size of Main** 8"

Repair—Renewal—New Service Dons Gradall #662 David Eagle #1060 **Location**

Date		Material	Amount	Total	Date			Amount
~~7-67~~	~~30'~~	~~6" Transite pipe~~						
/68	30'	6" Transite						
	10'	4" Cast Iron			7-7-	67		
						30'	6" Transite	

1.18501

DATE _____

TOWN OF LEXINGTON — BOARD OF PUBLIC WORKS

SEWER DIVISION

Sketch of Service Here **4**

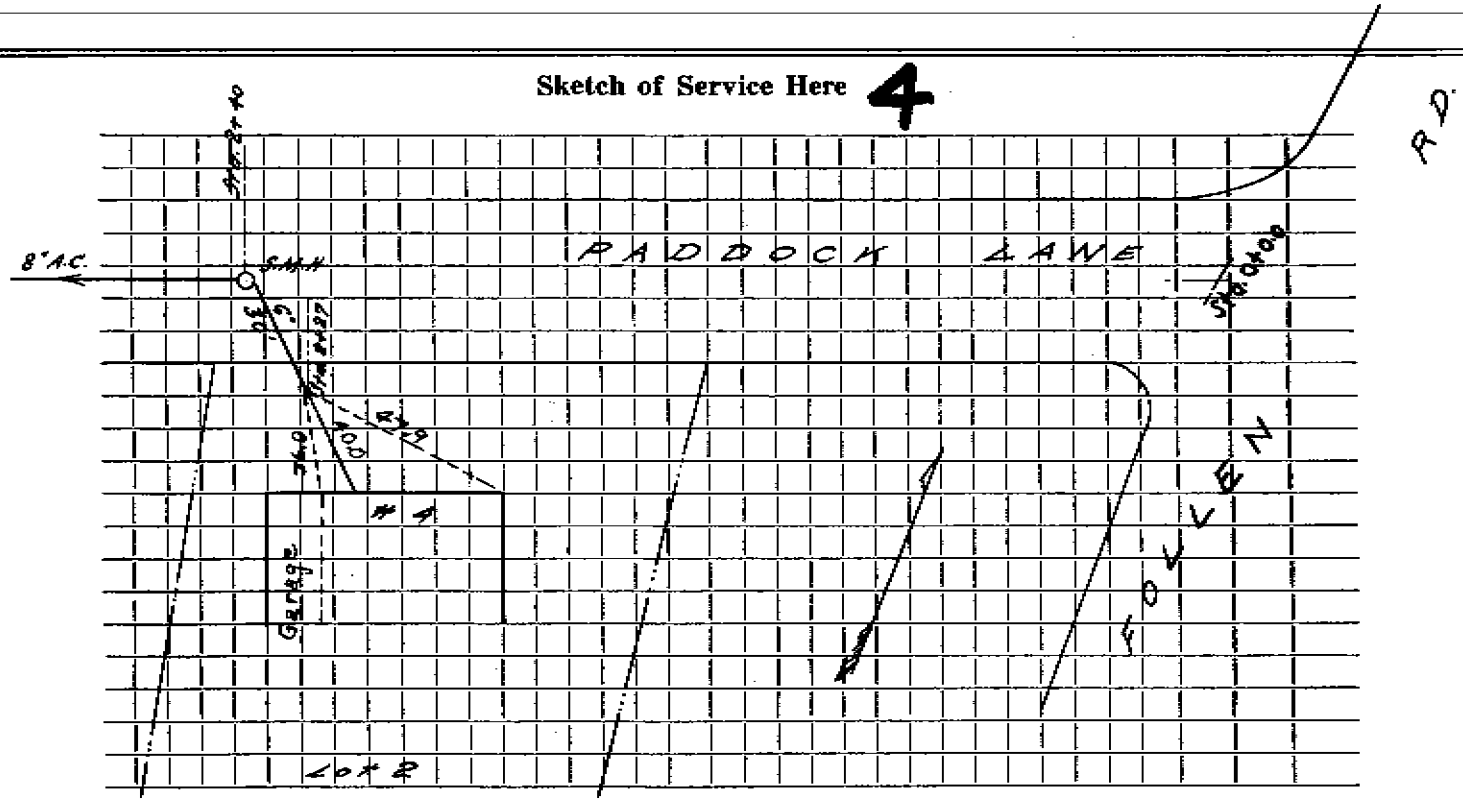

Connection made in ..... Street. Work completed .....

Remarks: .....

.....

.....