Name West Chester Estates **Service No.** 212

Address 11 Page Road

11 Page Road **Location**

Kind of Pipe **Size** 6" **Size of Main** 8"

~~[illegible]~~ **New Service** **Location** Com 11-21-60

Date		Material	Amount		Total		Date			Amount	
-4-59		Labor	6	14			11-7-60		Deposit	70	00
		10% O. H.		61	6	75	11-21-60	A	Refund	3	19
	20'	6" Transite pipe @.70			14	00				66	81
	1	Hr. Trucking				75					
					21	50					
		BILL WHEN CONNECTED									
-13-60		Labor	7	26							
		10% O.H.		73	7	99					
	44'	6" Transite pipe @78			34	32					
	1	Hr. Trucking @3.00			3	00					
					66	81					
								A	Applied to [illegible]		

8501

DATE _____

TOWN OF LEXINGTON — BOARD OF PUBLIC WORKS

SEWER DIVISION

Sketch of Service Here

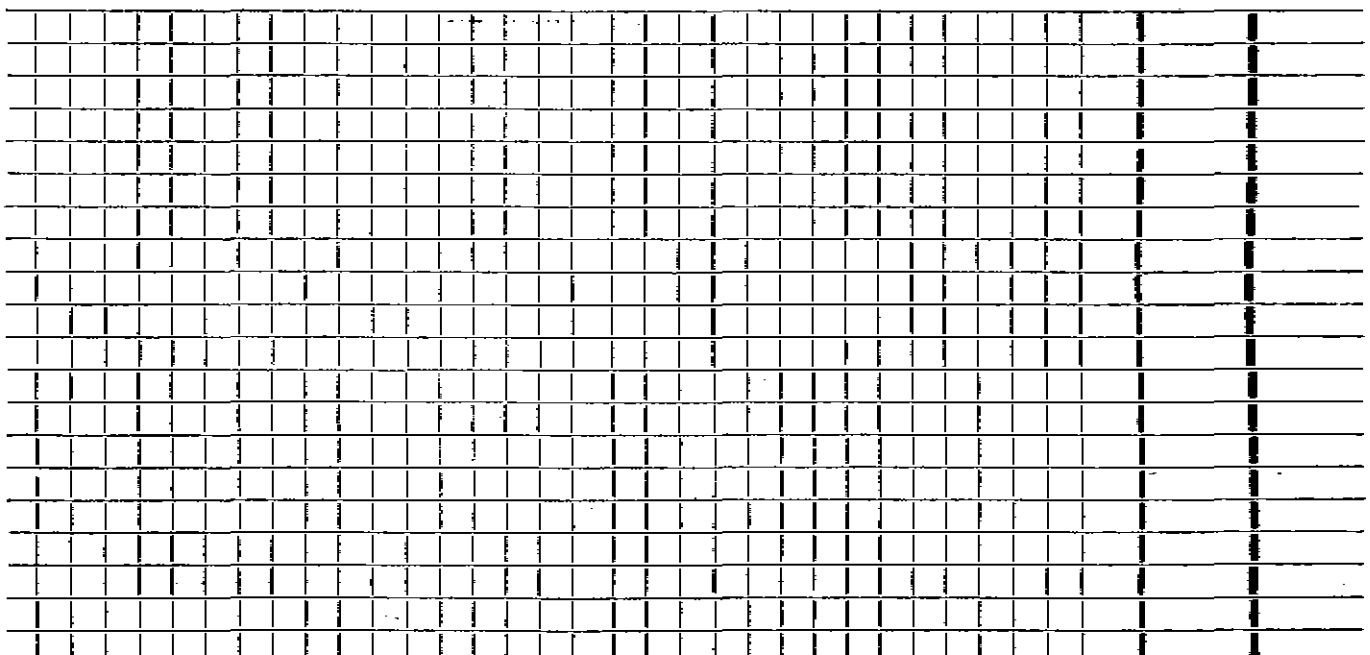

Connection made in ..... Street. Work completed .....

Remarks: .....

.....

.....