Name Allen Criss

Service No. 176

Address #18 Partridge Rd.

18 ParTridge Road

Location

FEB 12 1973

Kind of Pipe Transite

Size 6"

Size of Main 10"

Repair—Renewal—New Service Lucente #2178

Location

Date		Material	Amount		Total		Date			Amount	
1972	20'	6" Transite @ 7.50	150.	00			11/21/72		Deposit	150	00
11/15/72	81'	6" Transite					1972				
	6'	4" Cast Iron						20'	6" TRANSITE		

B.N.18501

DATE _____

TOWN OF LEXINGTON — BOARD OF PUBLIC WORKS

SEWER DIVISION

18

Sketch of Service Here

Lot 67

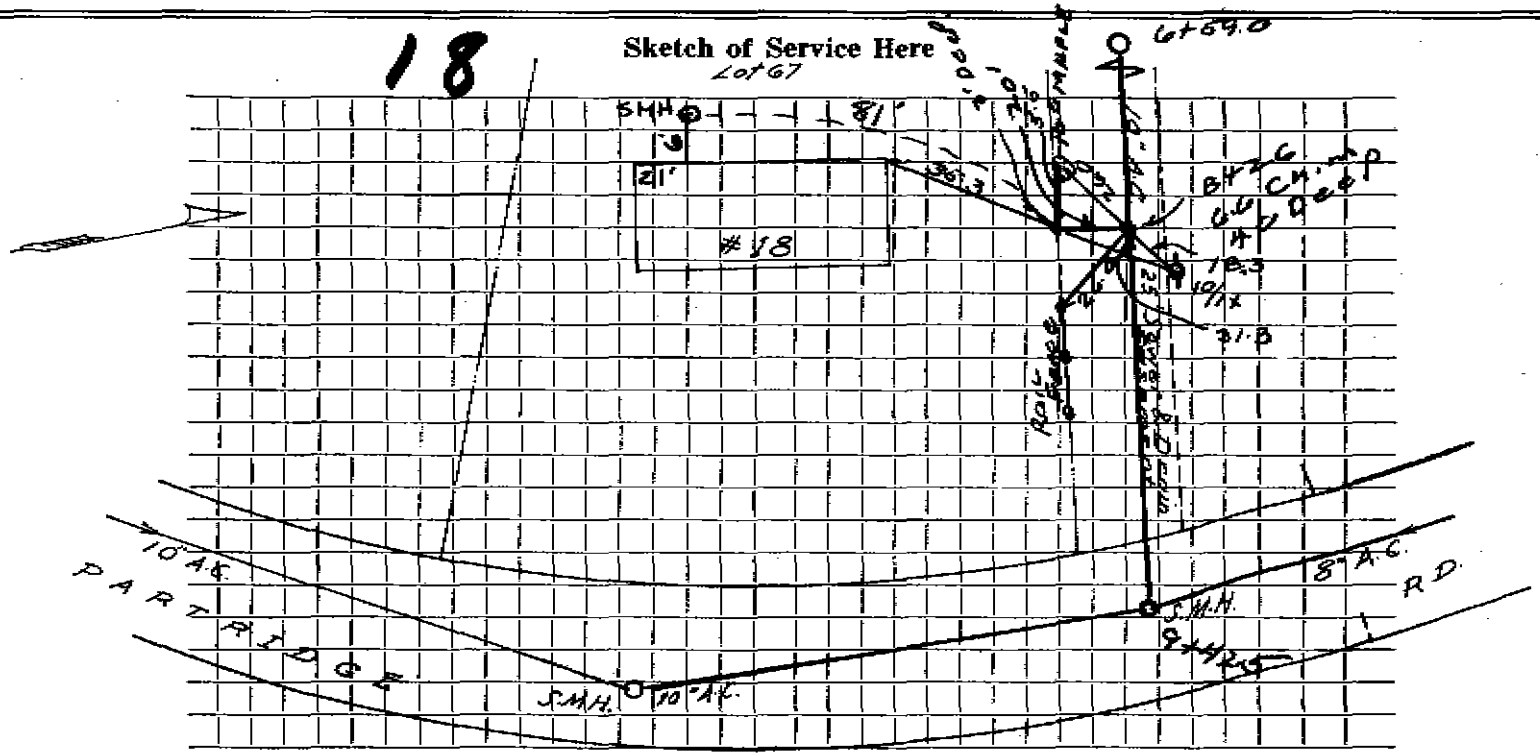

Connection made in ..... Street. Work completed .....

Remarks: .....

M.H. Clean out under Deck