Name Dr. George Goldman Service No. 158

Address # 20 Partridge Rd.

20 Partridge Road Location Lot 68A Feb. 12 1973

Kind of Pipe Size 6" Size of Main 8"

Repair—Renewal—New Service Lucente #2223 Location

Date	Material	Amount	Total	Date		Amount
~~1972~~	~~19' 6" ACP~~			10-18-72	Deposit	142.00
	@ 7.50	142.00				
				1972		
10-26-72	67.5' 6" ACP				19' 6" Transite	
	26' 4" C.I.				1 6"X10" Wye	

L.B.K.18501

DATE _____

TOWN OF LEXINGTON — BOARD OF PUBLIC WORKS

SEWER DIVISION

Sketch of Service Here 20

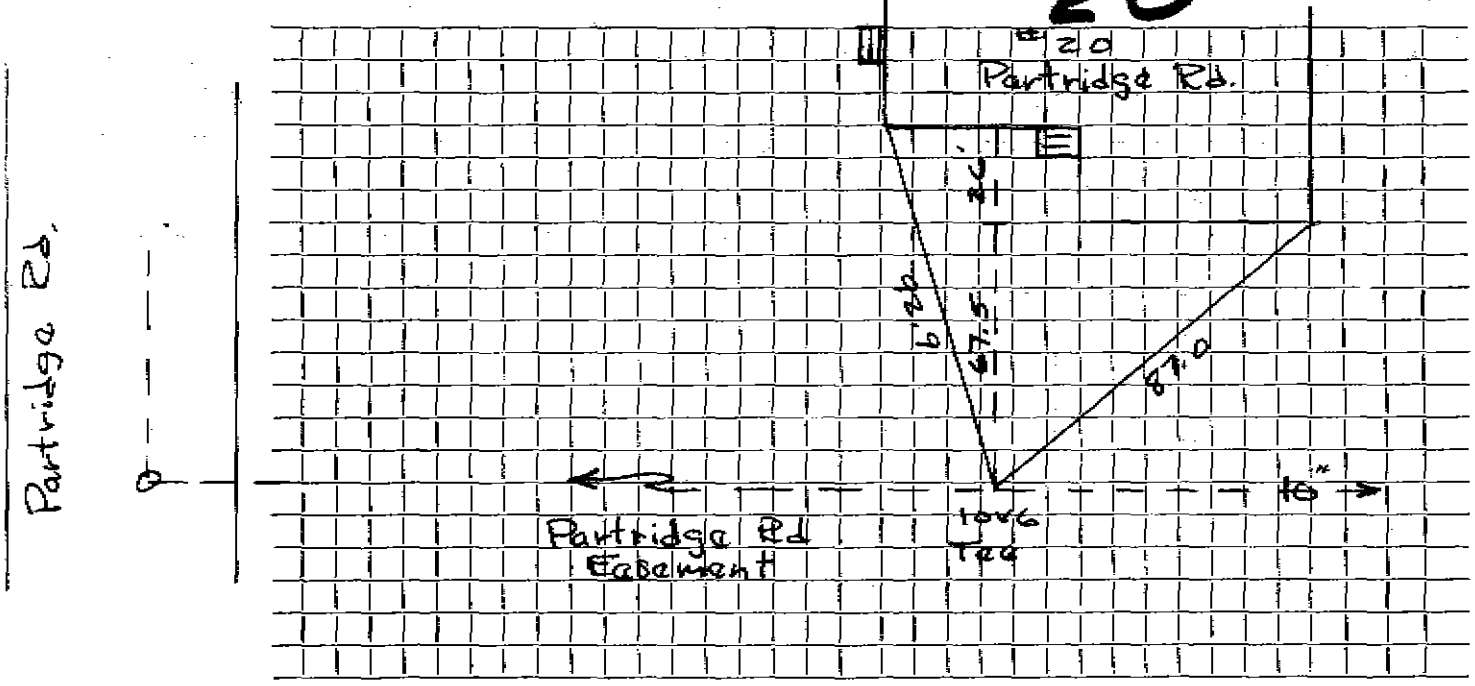

Connection made in ..... Street. Work completed .....

Remarks: .....

.....

.....