Name Lloyd Gilson **Service No.** 77 (75)

Address 35 Partridge Rd.

35 Partridge Road **Location**

Kind of Pipe AC **Size** 6" **Size of Main** 8"

Repair—Renewal—New Service Russell Sibley #2901 **Location** AUG 16 1976

Date	Material	Amount	Total	Date		Amount
~~11-21-74~~	~~26' 6" AC~~	~~$10.00~~	~~$260.00~~	8-7-75	Deposit	260 00
10/28/75	150' 6" Transite Pipe					
	20' 4" Cast Iron Pipe			11-21-74		
					26' 6" Transite	
					1 6"X8" Wye	

F.6.K.16501

DATE _____

TOWN OF LEXINGTON — BOARD OF PUBLIC WORKS

SEWER DIVISION

35 Sketch of Service Here

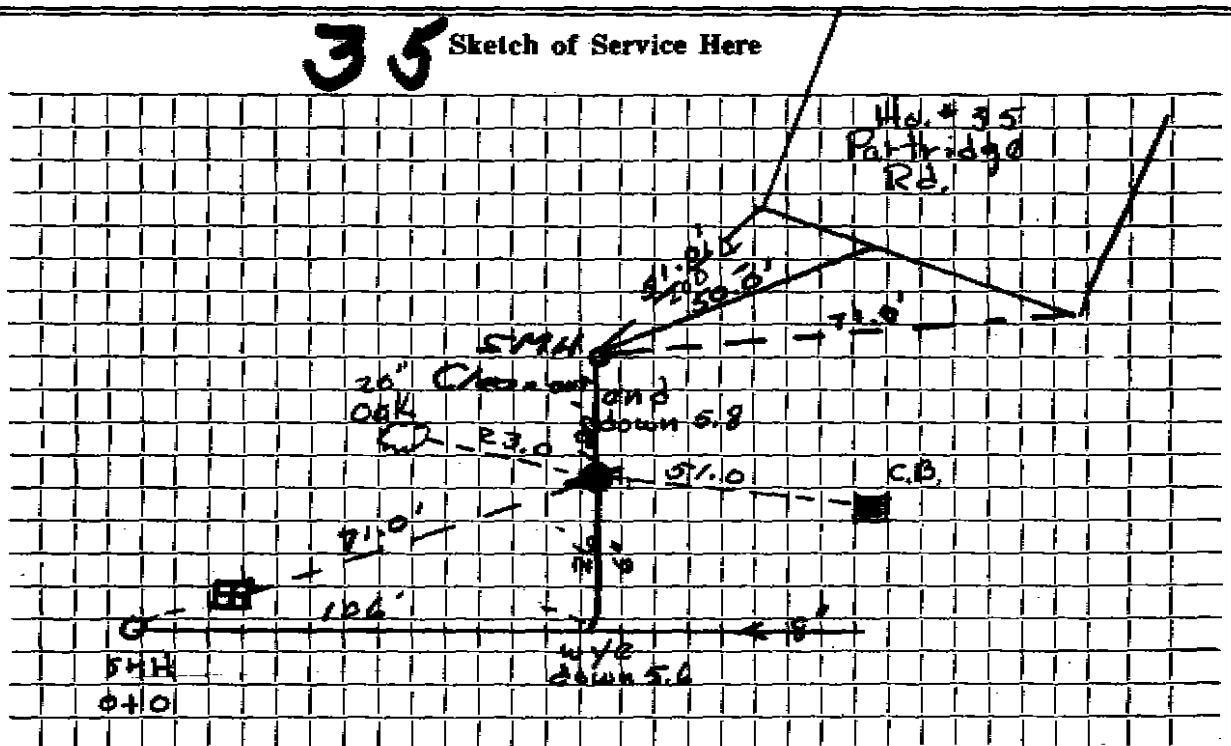

Connection made in #35 Partridge Rd. Street. Work completed 10/28/75

Remarks: .....