Name Windmere Group — Service No.

Address 4 Patriots Drive — Dig Safe No 974-605-971

Location

Kind of Pipe P.V.C. — Size 6" — Size of Main

Repair—Renewal—~~New Service~~ Permit #1043 J.M. McLaughlin — Location

Date		Material	Amount	Total	Date		Amount
1-22	98	8' 4" P.V.C.					
		39 6" P.V.C.					
		1 4x6 Ferneo					
		1 6x6 Ferneo					

DATE 1-22-98

TOWN OF LEXINGTON — BOARD OF PUBLIC WORKS

SEWER DIVISION

Sketch of Service Here

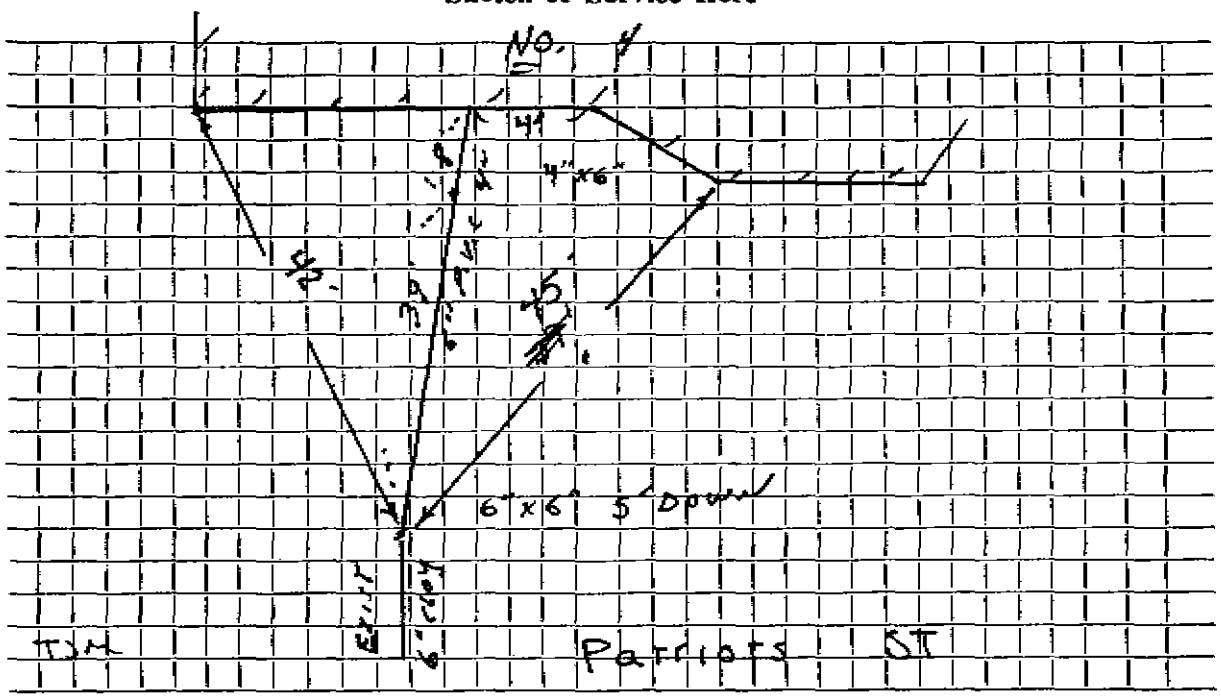

Connection made in PATRIOTS **Street.** **Work completed** .....

Remarks: .....

.....

.....