Name **Service No.**

Address 28 Patterson Rd

Repair by TCD Construction **Location** Tewksbury

Kind of Pipe Tom Babineau **Size** **Size of Main**

Repair—Renewal—New Service 978 - 423 - 3253 **Location**

Date	Material	Amount	Total	Date		Amount
3/5/12	Repaired	w/ 6"	PVC			

DATE 3/5/12

TOWN OF LEXINGTON — BOARD OF PUBLIC WORKS

SEWER DIVISION

28 Patterson

Sketch of Service Here

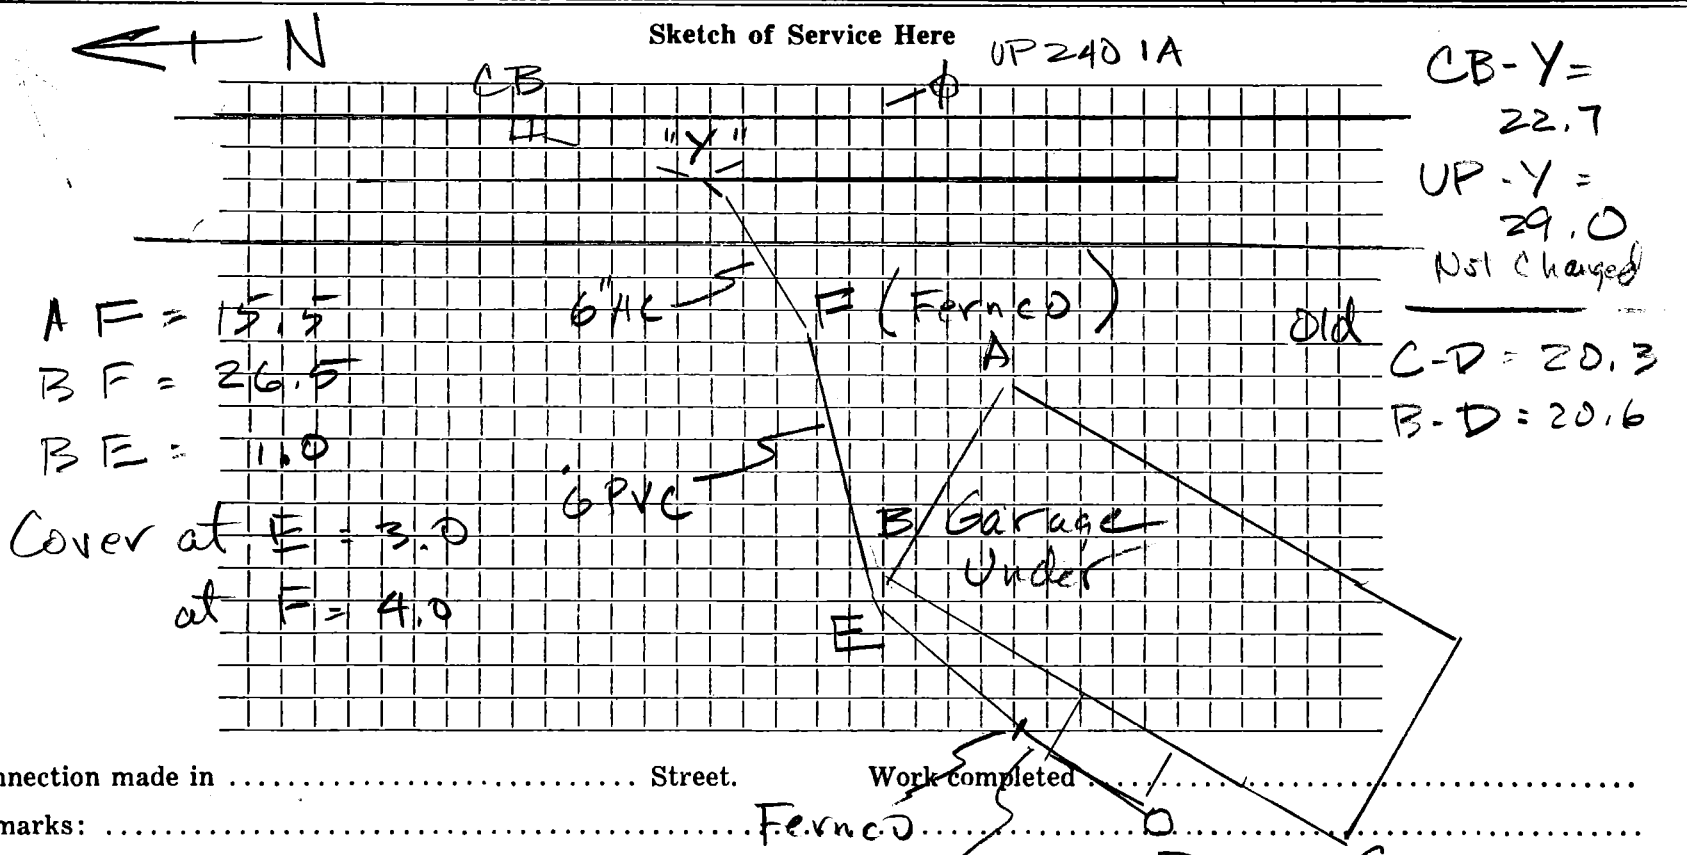

Connection made in ..... Street. Work completed ...../...../.....

Remarks: ..... Fernco ..... D .....

..... A C ..... C .....

..... M F Lanang, 3/6/12 ..... SMH .....