Name Chisholm Construction Company **Service No.** 55

Address 46 Paul Revere Road

46 Paul Revere Road **Location**

Kind of Pipe **Size** 6" **Size of Main** 8"

[redacted] New Service W.O. #309 Lexington Sewerage Permit #295 **Location** MAR 14 1966

Date		Material	Amount		Total		Date			Amount	
/65		Labor	66	24			5-17-65		Deposit	125	00
		O.H. 10%	6	62	72	86	3-14-66		Paid by W.O. #40	4	30
	~~301~~	~~6" Transite pipe~~ @ .82			24	60	5-21-	65		129	30
	~~1~~	~~6 x 8 Service saddle~~			5	25		30'	6" Transite		
	~~1~~	~~6" Elbow~~			4	09		1	6" Elbow		
	1	Hr. Town Truck			3	00		1	6"x8" Wye		
	3	Hrs. Town Shovel @ 6.50			19	50					
					129	30					
-65	28'	6" Transite pipe									

DATE _____

TOWN OF LEXINGTON — BOARD OF PUBLIC WORKS

SEWER DIVISION

Sketch of Service Here 46

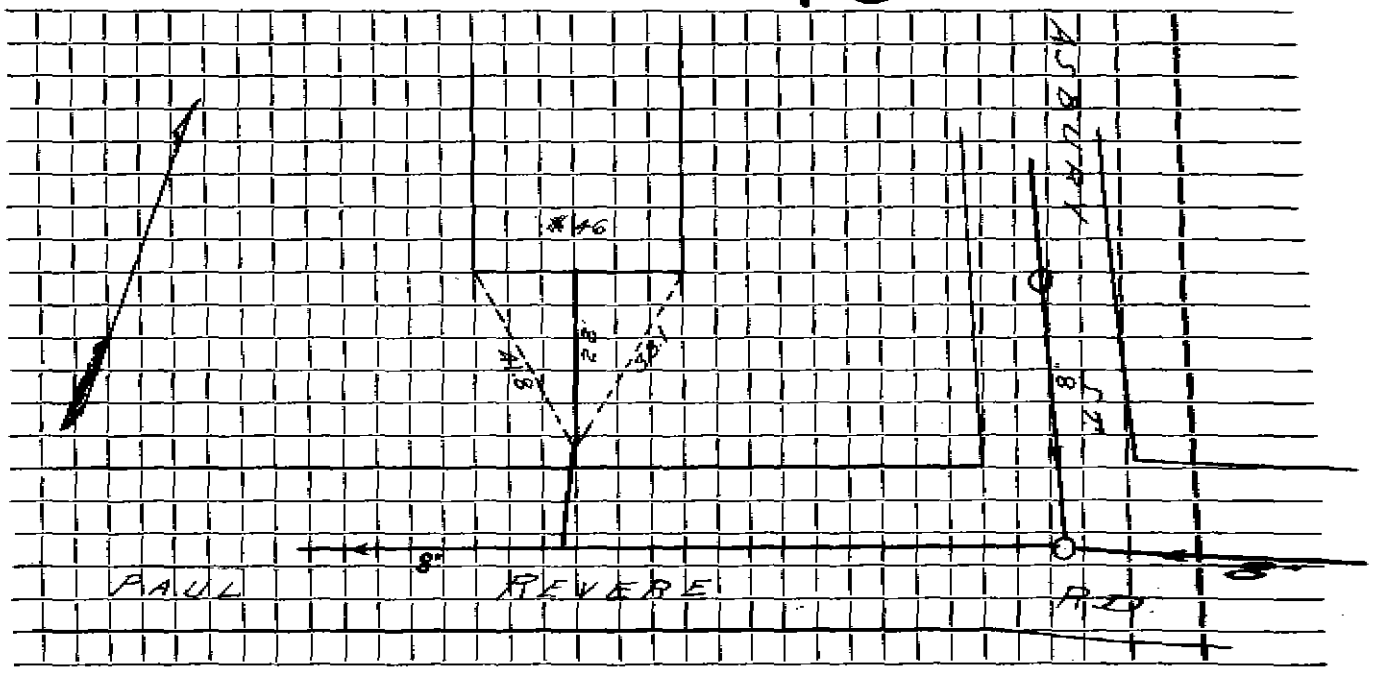

Connection made in ..... Street. Work completed .....

Remarks: .....

.....

.....