Name HAMILTON COMPANY Service No.

Address #77 PAUL REVERE ROAD

77 Paul Revere Road Location

Kind of Pipe Size 6" Size of Main 8"

Repair Renewal New Service PERMIT NO. 0718 McLaughlin Location

Date	Material	Amount	Total	Date		Amount
10-30-55	77'-6" PVC					
	6'-4"					

DATE 2 NOVEMBER 1995

TOWN OF LEXINGTON — BOARD OF PUBLIC WORKS

SEWER DIVISION

Sketch of Service Here 77

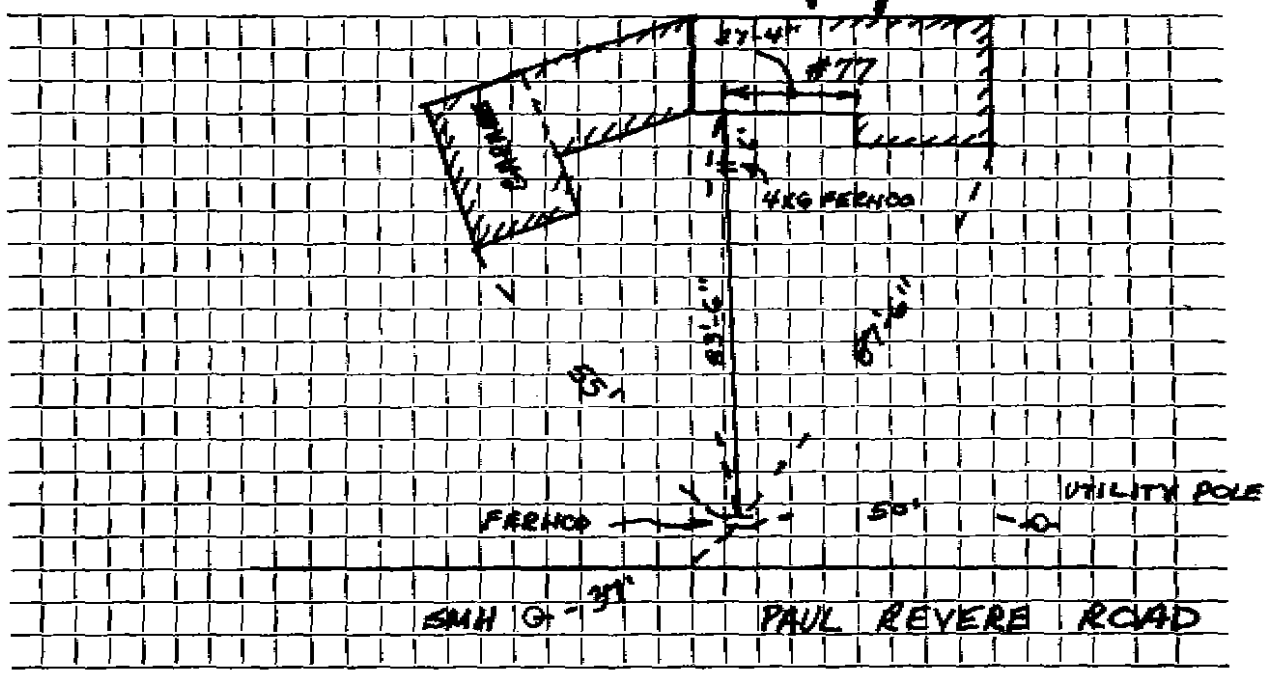

Connection made in PAUL REVERE ROAD Street. Work completed J.M. MCLAUGHLIN, INC.

Remarks:

BOOK 96A

J.W.