Name | **Service No.**

Address 12 Peacock Farm Road

12 Peacock Farm Rd. **Location**

Kind of Pipe | **Size** 6" | **Size of Main** 8"

Repair—Renewal—New Service | **Location**

Date		Material	Amount	Total	Date			Amount
0-21-	74							
	70'	6" Transite						
	6'	4" C.I. Pipe			10-7-	74		
						20'	6" Transite	
						1	6"-90° Elbow	
						1	6"-5' Nipple	

S.M.18501

DATE _____

TOWN OF LEXINGTON — BOARD OF PUBLIC WORKS

SEWER DIVISION

Sketch of Service Here 12

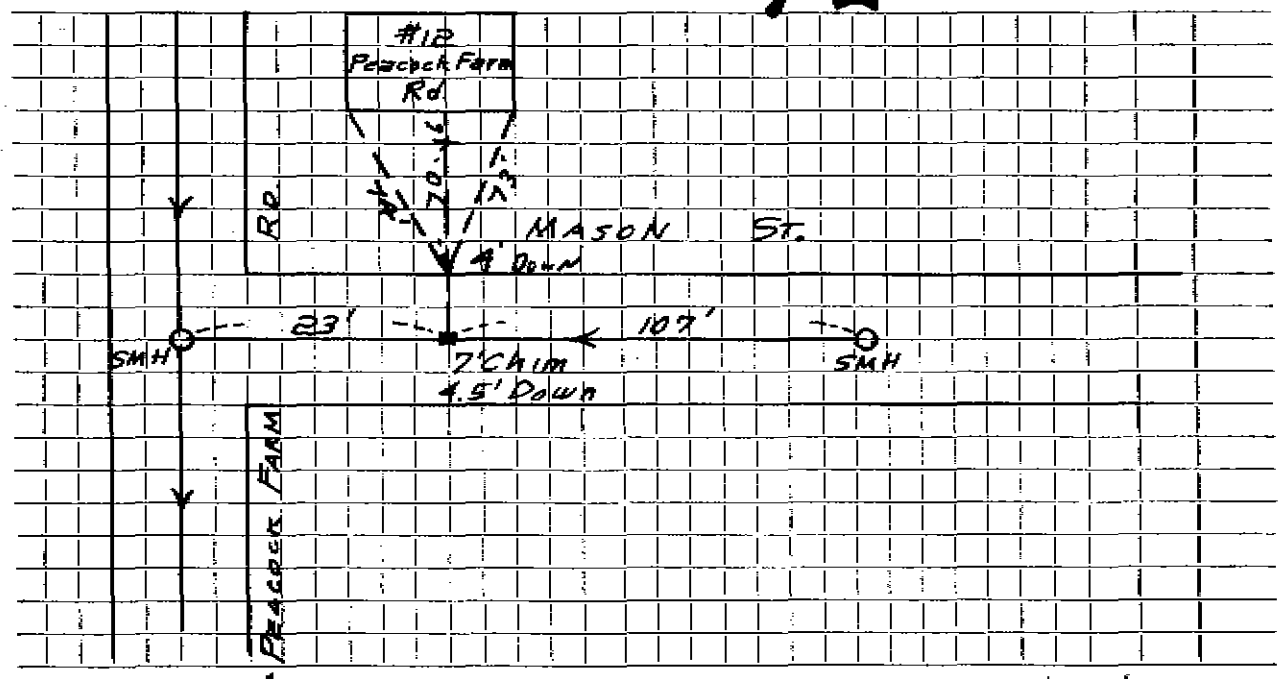

Connection made in MASON Street. Work completed 10/21/74

Remarks: .....