Name | Service No.

Address 3 PEACOCK FARM RD.

3 Peacock Farm Rd. Location

Kind of Pipe PVC & CI Size 4" & 3" Size of Main 8"

(Repair) Renewal New Service Coviello (Lic. Plumber) Location

Date		Material	Amount	Total	Date			Amount
11-29-	92	2 LF 4" CI						
		15 LF 4" PVC						
		28.5 LF 3" PVC			5-17-	67		
		3x4 CI WYE				5'	6" Sewer Pipe	
		3-3" 45° ELBOWS				1	6"-11¼° Elbow	
		3"x3" WYE C.O.				1	6"-11¼° Bend	
6-14-	67					1	6"-22½° Bend	
	100'	6" TYRANSITE						
	10'	4" C.I. Pipe						

NO PERMIT

EMERGENCY SERV.

DATE _____

TOWN OF LEXINGTON — BOARD OF PUBLIC WORKS

SEWER DIVISION

Sketch of Service Here

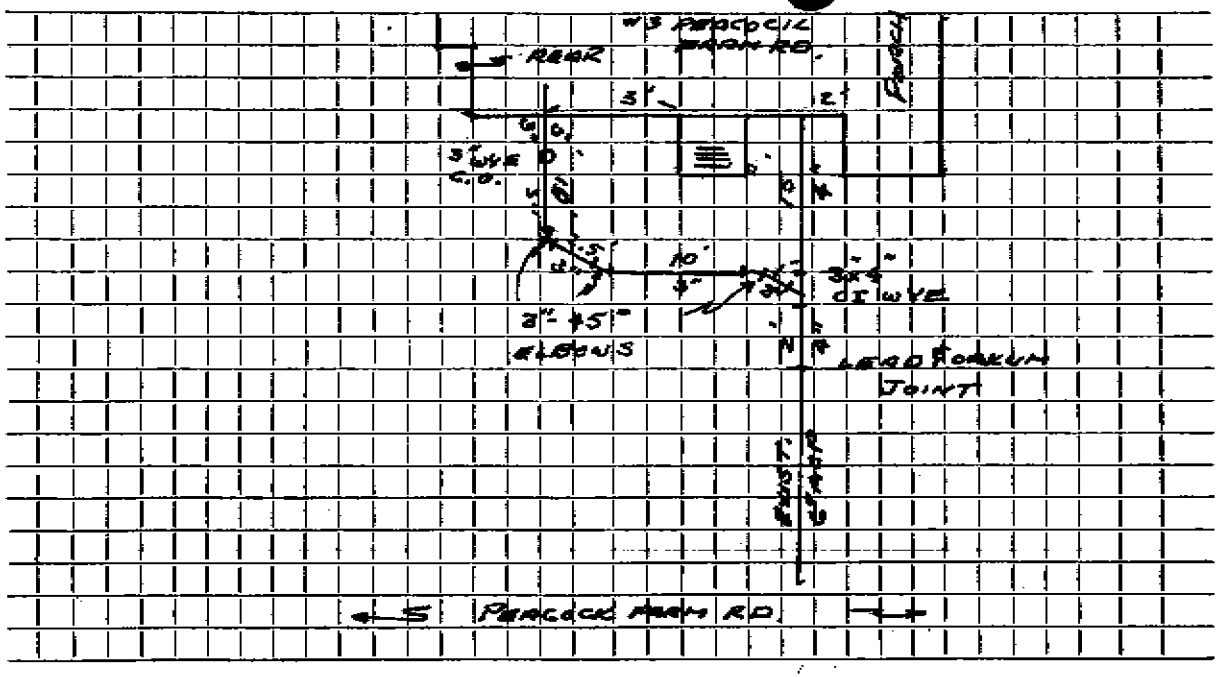

Connection made in PEACOCK FARM RD. Street. Work completed .....

Remarks: REPAIRED WHEN REMOVING OIL TANK