Name New LCP School Sewer Line **Service No.**

Address 20 Pelham Rd.

Location Rear of Bldg

Kind of Pipe PVC **Size** 8" **Size of Main**

Repair—Renewal—New Service **Location**

Date	Material	Amount	Total	Date		Amount
9/19	By School Site Contractor					

DATE 1/2/20

TOWN OF LEXINGTON — BOARD OF PUBLIC WORKS

SEWER DIVISION

Sketch of Service Here

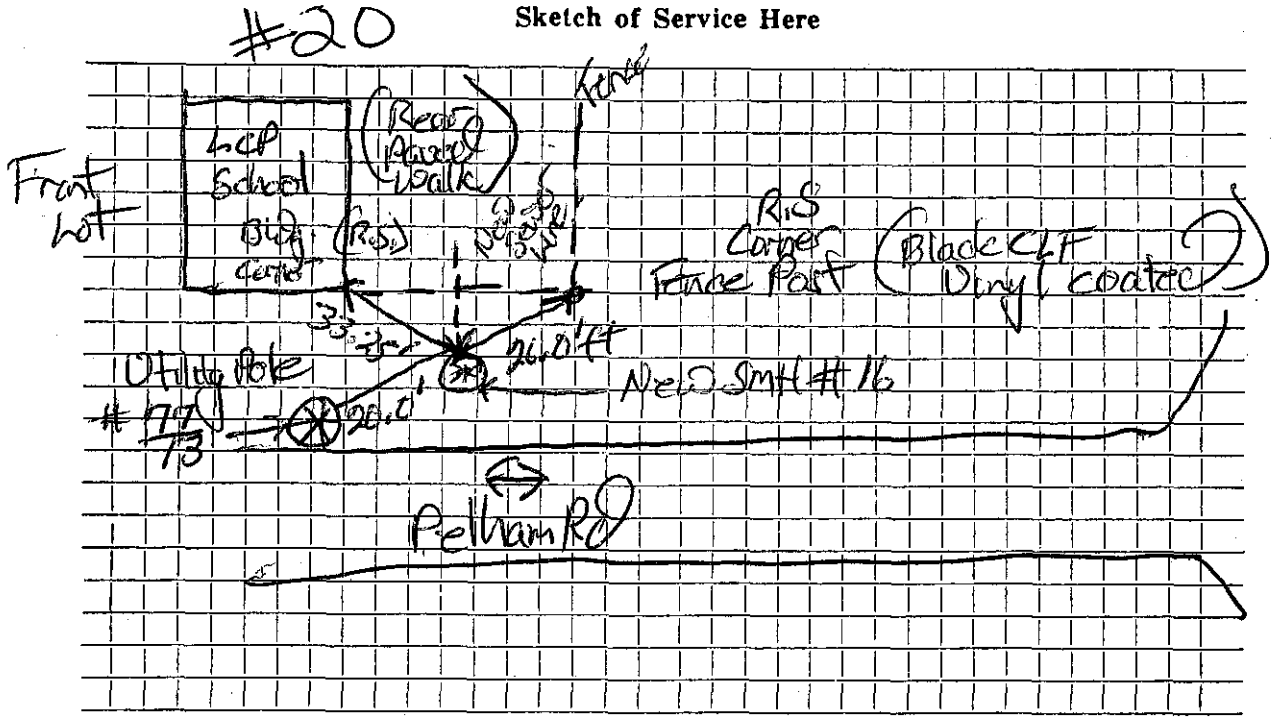

Connection made in .....Pelham..... Street. Work completed .....10/19.....

Remarks: .....

.....20 Pelham.....

.....