Name J. Frank Busa **Service No.**

Address 3 Pheasant Lane

Lot # 13 **Location**

Kind of Pipe **Size** 6" **Size of Main** 8"

Repair—Renewal—New Service Lucente #777 Dave Eagle #2116 **Location**

Date		Material	Amount	Total	Date			Amount
~~1/68~~	~~33'~~	~~Transite~~						
11/72	40'	6" Transite			6-11-	68		
	10'	4" Cast Iron				33'	6" Transite	
						1	6" x 8" Wye	

18501

DATE _____

TOWN OF LEXINGTON — BOARD OF PUBLIC WORKS

SEWER DIVISION

Sketch of Service Here 3

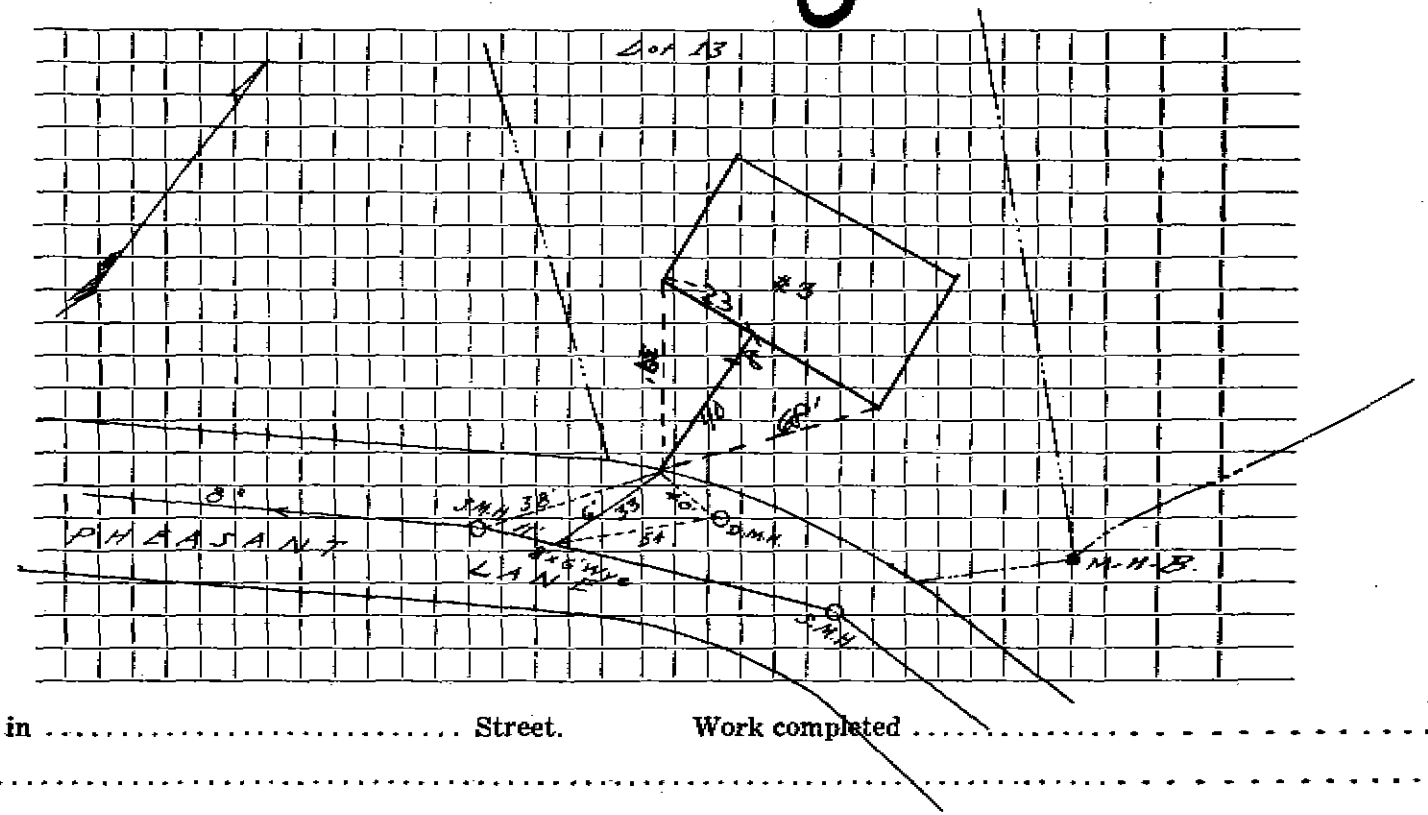

Connection made in ..... Street. Work completed .....

Remarks: .....

.....

.....