Name J.Frank Busa **Service No.**

Address 5 Pheasant Lane

Lot #12 **Location**

Kind of Pipe **Size** 6" **Size of Main** 8"

Repair—Renewal—New Service Lucente #778 Dave Eagle #2117 **Location**

Date		Material	Amount	Total	Date			Amount
~~11/68~~	~~33'~~	~~6" Transite~~						
/11/72	30'	6" Transite			6-11-	68		
	10'	4" Cast Iron				33'	6" Transite	
						1	6"X8" Wye	

K.18501

DATE _____

TOWN OF LEXINGTON — BOARD OF PUBLIC WORKS

SEWER DIVISION

Sketch of Service Here 5

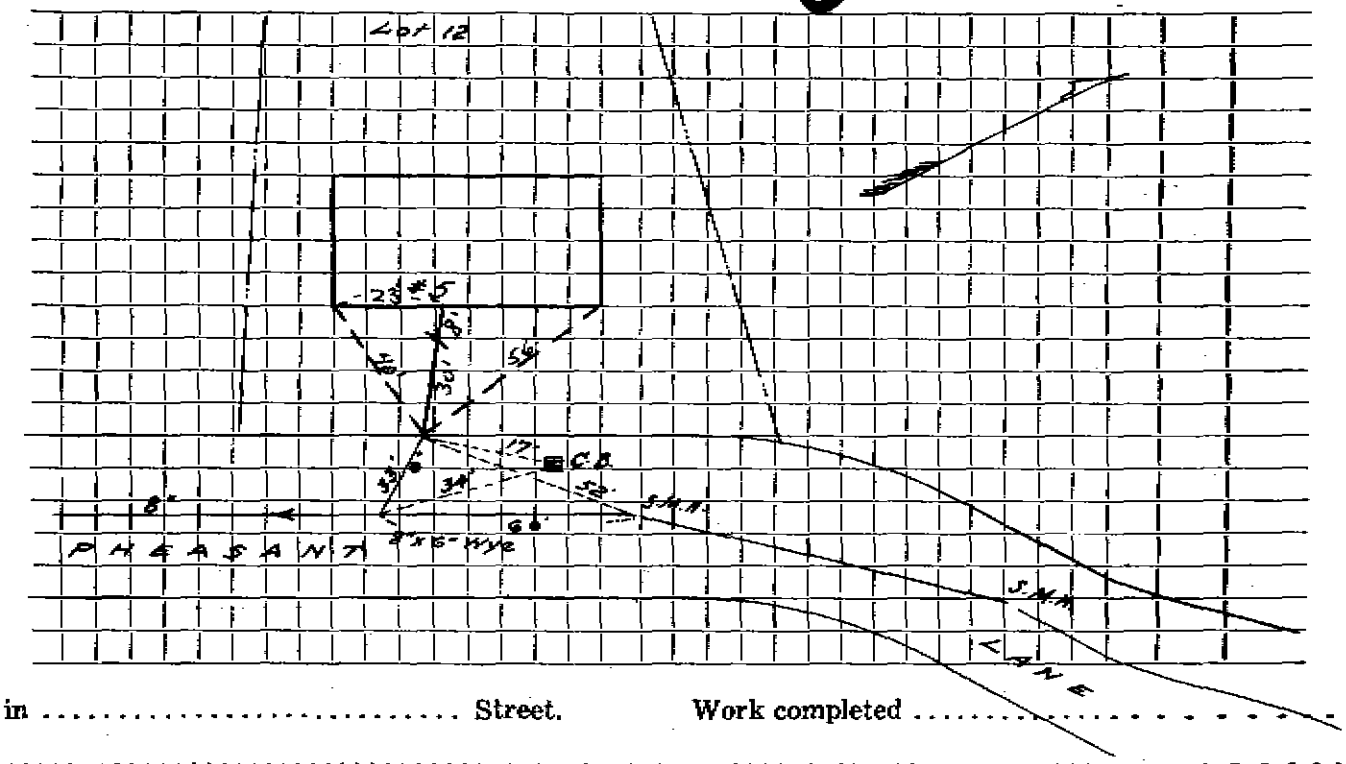

Connection made in ..... Street. Work completed .....

Remarks: .....

.....

.....