Name J. Frank Buss **Service No.**

Address 9 Pheasant Lane

Lot #10 **Location**

Kind of Pipe **Size** 6" **Size of Main** 8"

Repair—Renewal—New Service Glynn #1425 Lucente #782 **Location**

Date		Material	Amount	Total	Date			Amount
~~/11/68~~	~~52'~~	~~6" Transite~~						
1-69	30'	6" Transite pipe						
	10'	4" Cast Iron pipe			6-11-	68		
						29'	6" Transite	
						1	6"x8" Wye	

.18501

DATE _____

TOWN OF LEXINGTON — BOARD OF PUBLIC WORKS

SEWER DIVISION

Sketch of Service Here 9

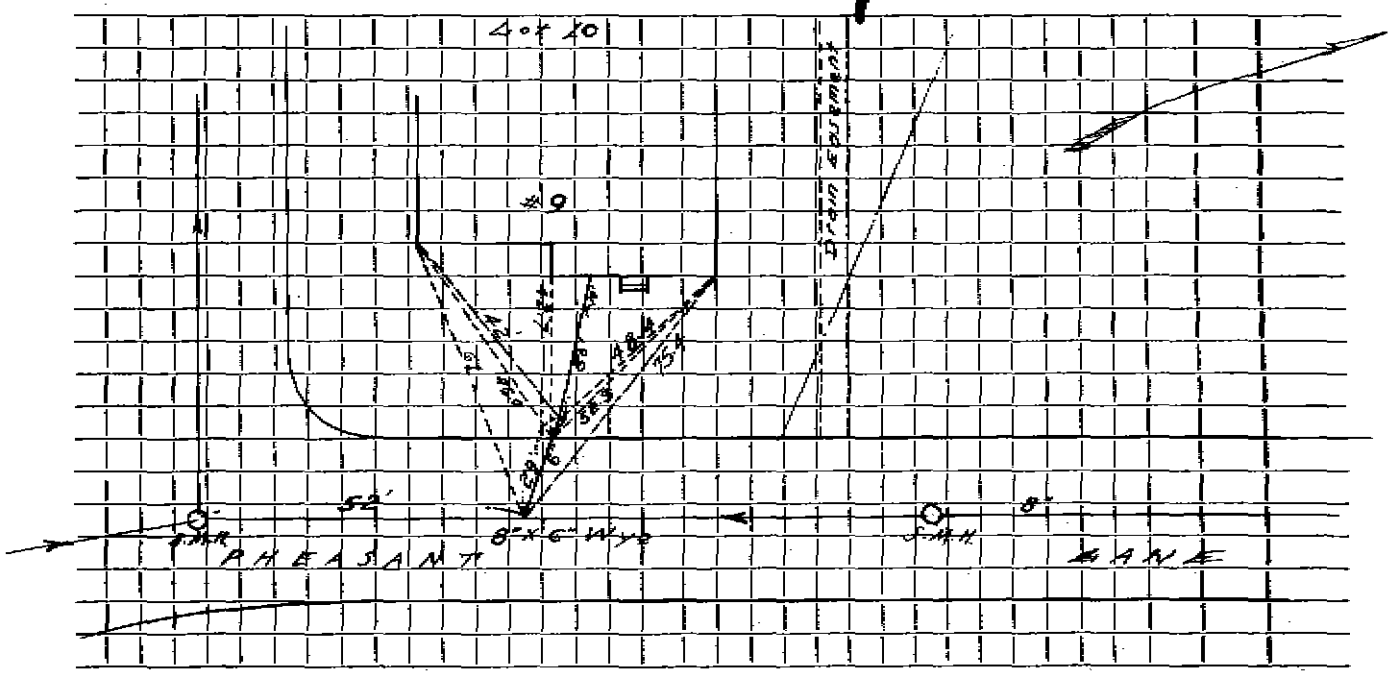

Connection made in ..... Street. Work completed .....

Remarks: .....

.....

.....