Name Robert Phelan Service No. 0pg

Address #5 Philbrook Terr.

5 Philbrook Terrace Location

Kind of Pipe PVC Size 6" Size of Main 8"

Repair—Renewal—New Service Redmond #4649 Location

Date	Material	Amount	Total	Date		Amount
7/15/88						
	(1) 6"x6" wye & cleanout					
	(1) 6"x4" Fernco					
	84 ft. 6" PVC.					

DATE _____

TOWN OF LEXINGTON — BOARD OF PUBLIC WORKS

SEWER DIVISION

Sketch of Service Here 5

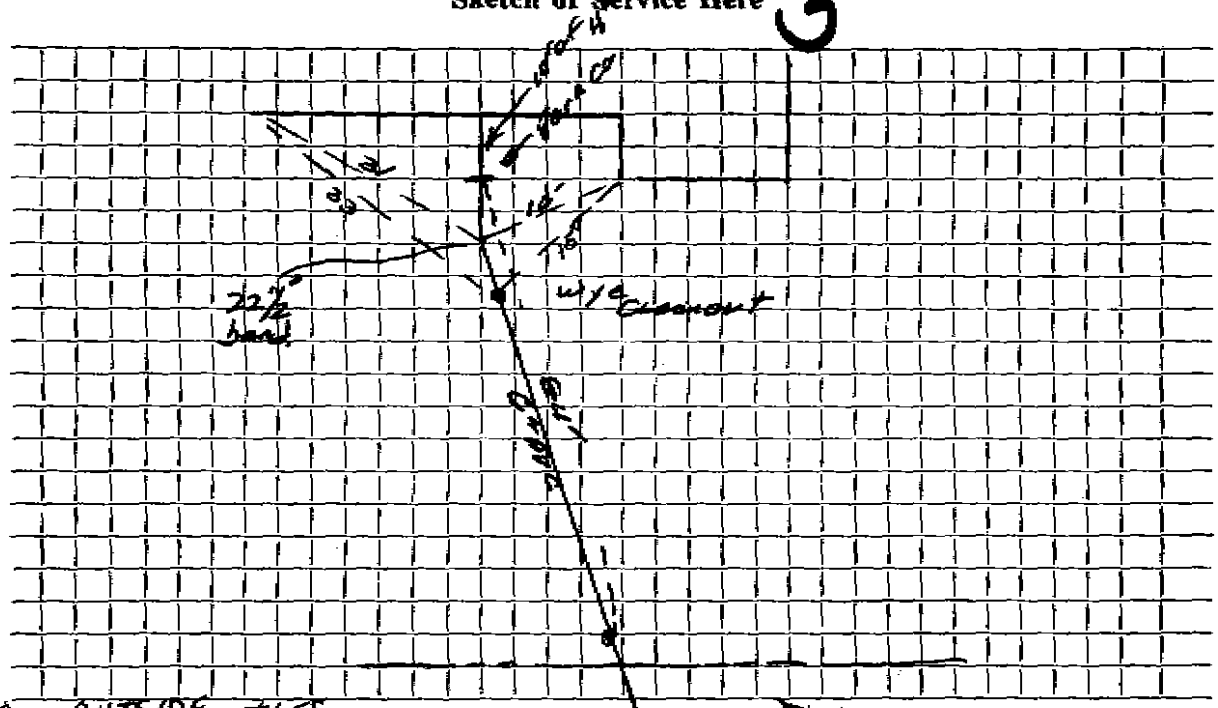

NOTE: No OUTSIDE TIES

Connection made in PHILBROOK TERR. Street. Work completed .....

Remarks: .....

.....

.....