Name Duffy Bros. **Service No.**

Address 22 Philip Road

Lot #190 22 Philip Road **Location**

Kind of Pipe **Size** 6" **Size of Main** 8"

Repair—Renewal—New Service Bonanno A328 **Location**

Date		Material	Amount	Total	Date			Amount
~~3/66~~	~~36'~~	~~6" Transite pipe~~						
4/67	39'	6" Transite pipe						
	10'	4" Cast Iron			6-23-	66		
						36'	6" Transite	
						1	6" X 8" Wye	

18501

DATE _____

TOWN OF LEXINGTON — BOARD OF PUBLIC WORKS

SEWER DIVISION

Sketch of Service Here 22

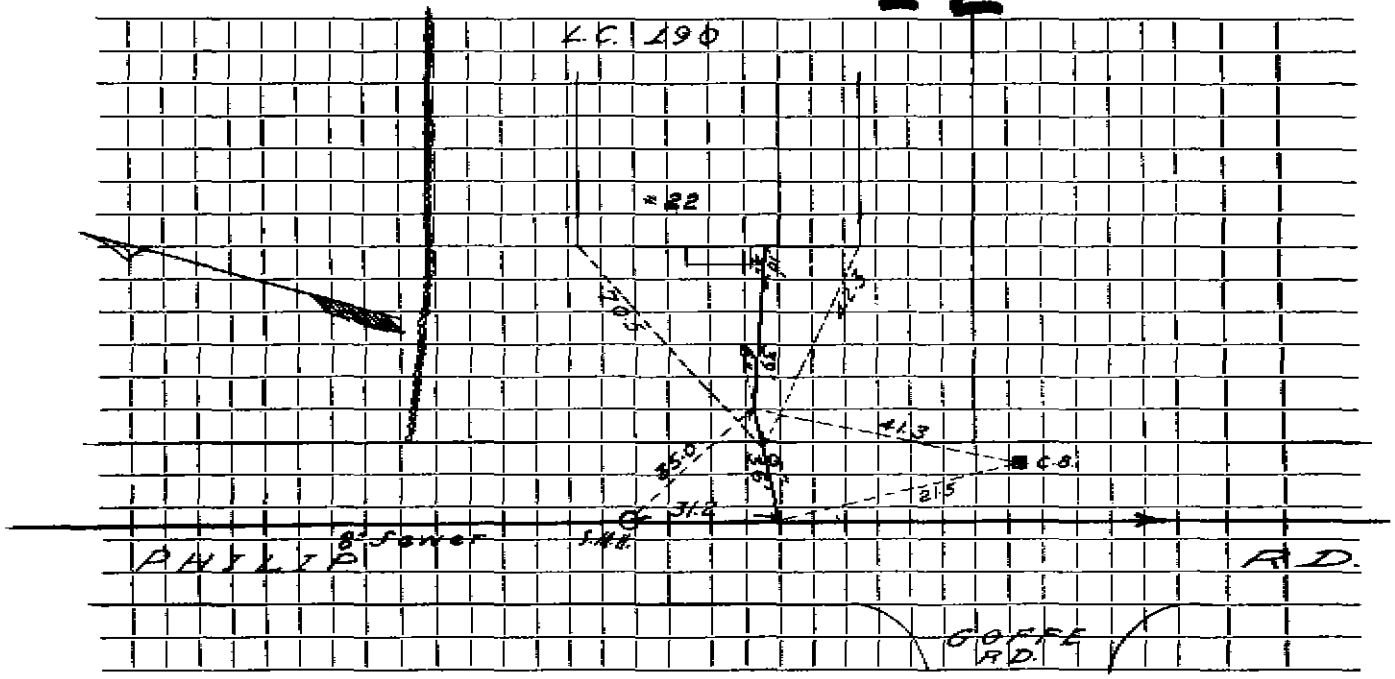

Connection made in ..... Street. Work completed .....

Remarks: .....

.....

.....