Name Minute Man Estates **Service No.**

Address ~~[illegible]~~ 29 Philip Road

29 Philip Road **Location**

Kind of Pipe **Size** 6" **Size of Main** 8"

~~[illegible]~~ **New Service** Nick Bonanno **Location**

Date		Material	Amount	Total	Date		Amount
		62'					
1-66	68'	6" Transite pipe					
	12'	Cast Iron Pipe					

LB501

DATE _____

TOWN OF LEXINGTON — BOARD OF PUBLIC WORKS

SEWER DIVISION

Sketch of Service Here 29

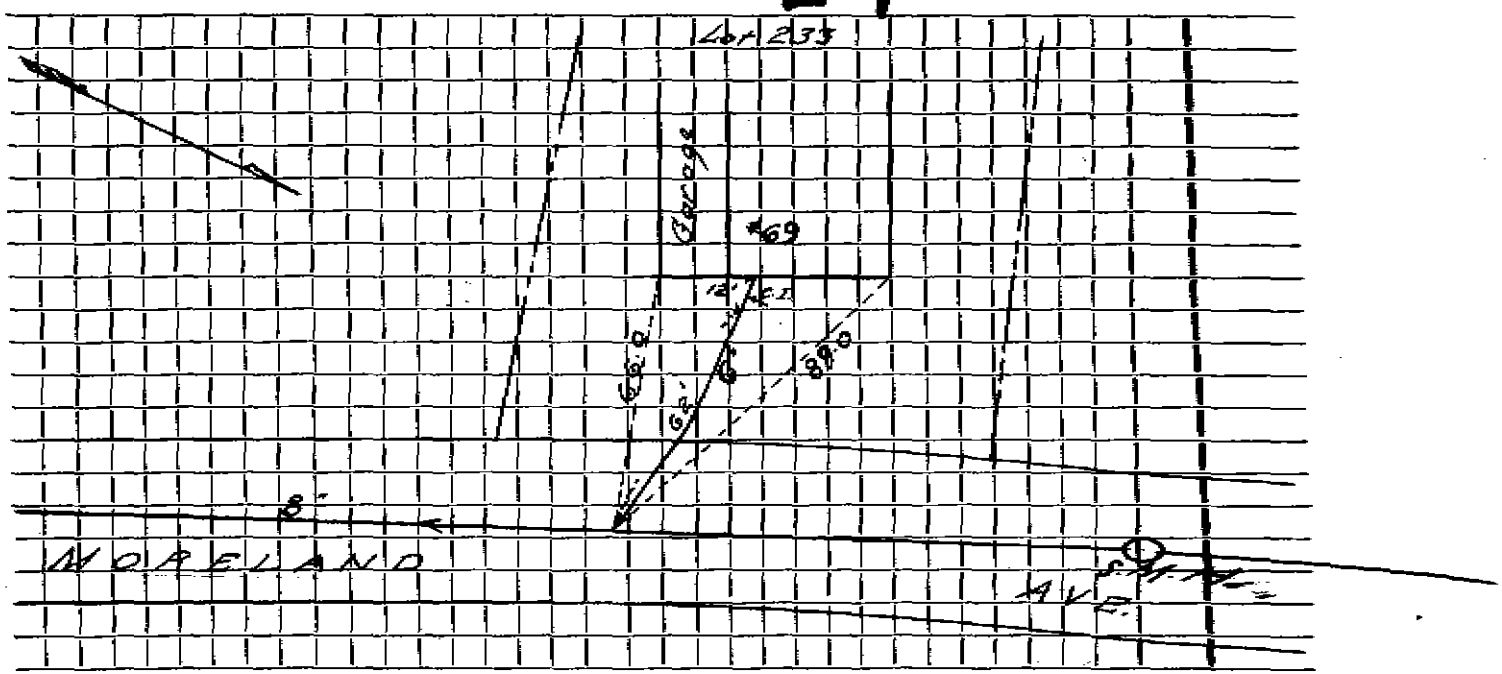

Connection made in ..... Street. Work completed .....

Remarks: .....

.....

.....