Name Duffy Const. Co. **Service No.**

Address ~~[illegible]~~ 37 Philip Road

Lot #221 37 Philip Road **Location**

Kind of Pipe John J. Flannery Permit #A85 **Size** 6" **Size of Main** 8"

~~[illegible]~~ **New Service** **Location**

Date		Material	Amount	Total	Date		Amount
/13/66	72'	6" Transite pipe					

16501

DATE _____

TOWN OF LEXINGTON — BOARD OF PUBLIC WORKS

SEWER DIVISION

Sketch of Service Here 37

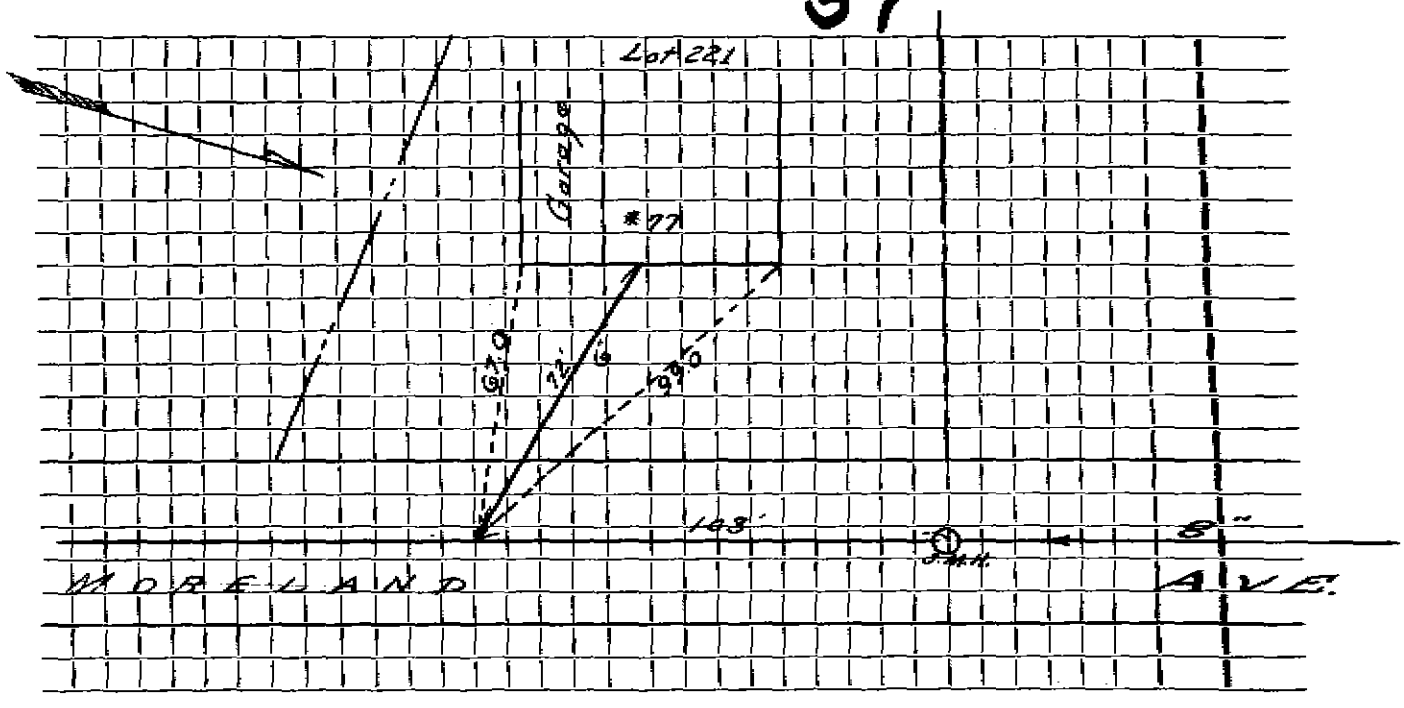

Connection made in ..... Street. Work completed .....

Remarks: .....

.....

.....