Name Duffy Const. Co. **Service No.**

Address ~~[illegible]~~ 38 Philip Road

Lot #198 38 Philip Rd. **Location**

Kind of Pipe John J. Flannery Permit #A91 **Size** 6" **Size of Main** 8"

~~Repair Renewal~~ **New Service** **Location**

Date		Material	Amount		Total		Date			Amount	
1/17/66	61'	6" Transite pipe									

DATE

TOWN OF LEXINGTON — BOARD OF PUBLIC WORKS

SEWER DIVISION

Sketch of Service Here 38

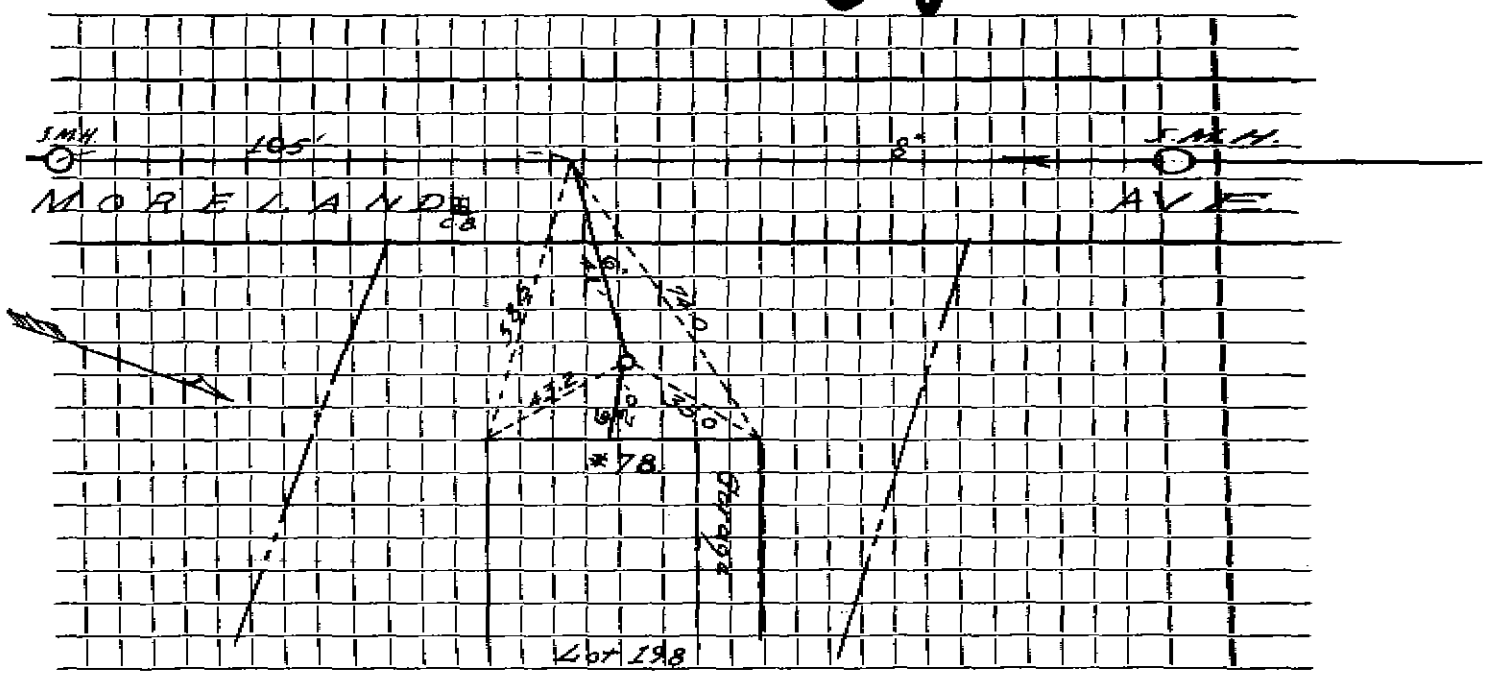

Connection made in ..... Street. Work completed .....

Remarks: .....

.....

.....