Name William Sullivan **Service No.** 27

Address 9 Phinney Road

Station 3 / 73 Lot 378 (6'9" Deep) **Location**

Kind of Pipe **Size** 6" **Size of Main** 8"

~~[illegible]~~ **New Service** Russell Sibley Permit #233 **Location** MAY 17 1965

Date		Material	Amount		Total		Date			Amount
10/19/61		Labor	14	14			4-6-65		Deposit	38.83
		10% O.H.	1	41	15	55				
	~~26'~~	~~6" Transite Pipe~~ @ .78			20	28	10-19-61			
	1	Hr. Trucking @ 3.00			3	00		26'	6" Transite	
		BILL WHEN CONNECTED			38	83		1	6"x 8" Wye	
4-8-65	22'	6" Transite pipe								

L.S.-M.18501

DATE _____

TOWN OF LEXINGTON — BOARD OF PUBLIC WORKS

SEWER DIVISION

Sketch of Service Here 9

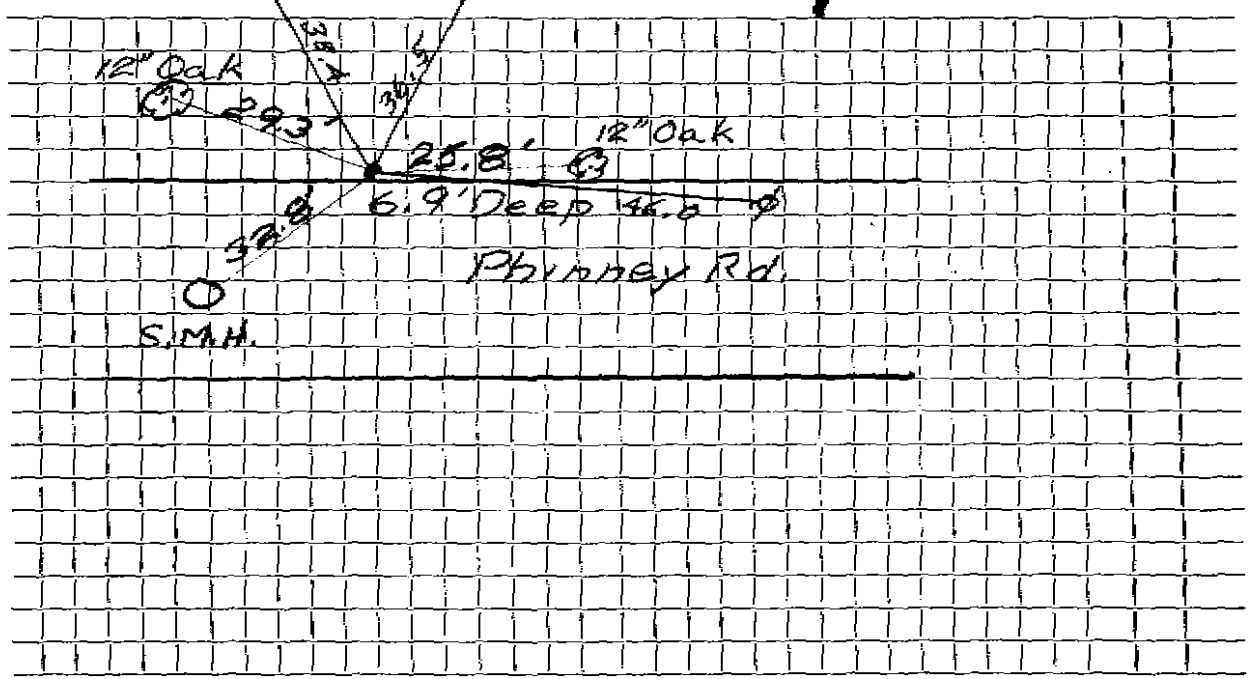

Connection made in ..... Street. Work completed .....

Remarks: .....

.....

.....