Name Dorothy Johnson **Service No.** 44

Address 19 Pine Knoll Road

19 Pine Knoll Rd. **Location**

Kind of Pipe **Size** 6" **Size of Main** 8"

Repair—Renewal—New Service Ferrari #1613 **Location** JUL 27 1970

Date		Material	Amount	Total	Date		Amount
~~1970~~	~~19'~~	~~6" Transite pipe~~ @8.00		136.00	6-16-70	Deposit	136.00
-24-70	20'	6" Transite pipe					
	19'	4" Cast Iron pipe			1970		
						17' 6" Transite	

L.18501

DATE _____

TOWN OF LEXINGTON — BOARD OF PUBLIC WORKS

SEWER DIVISION

Sketch of Service Here 19

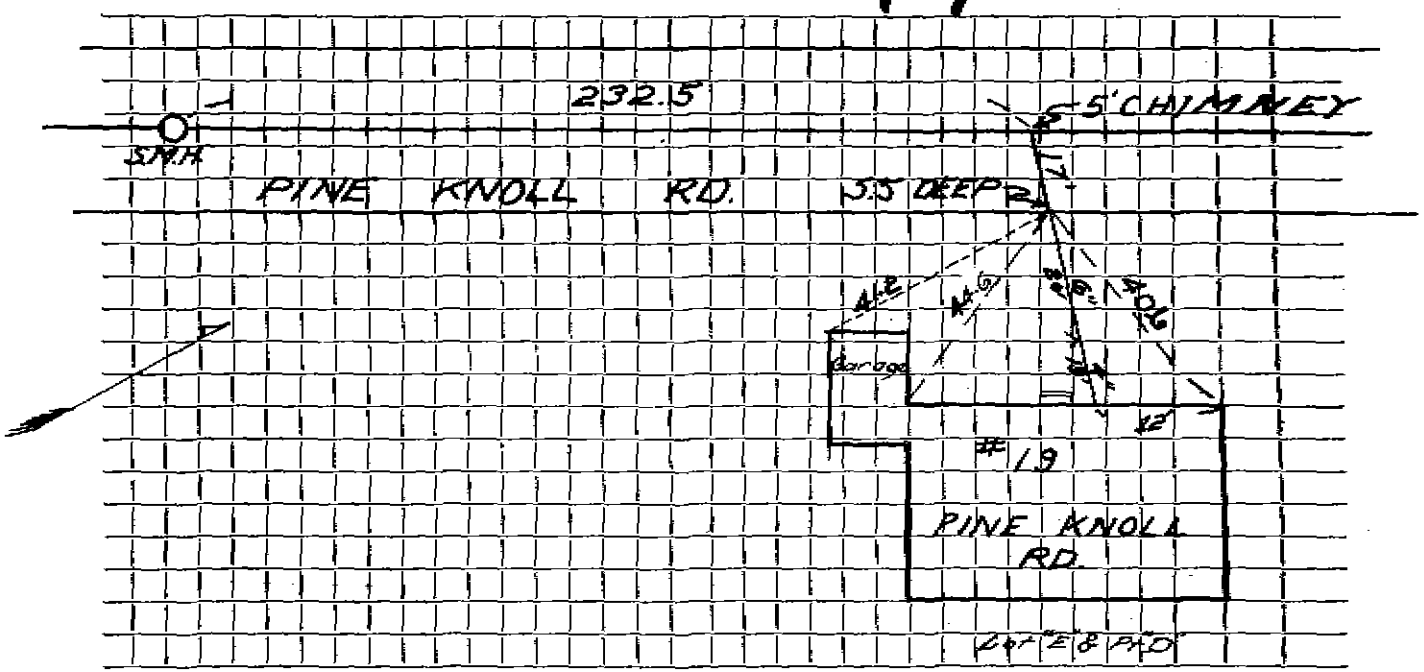

Connection made in ..... Street. Work completed .....

Remarks: .....

.....

.....